SURVEY & RECONNAISSANCE

FEB 18 1994

COMMISSION

LAND CORNER RECORDATION CERTIFICATE
Filing Requirement of Act 74, Mich. P.A. 1970

Register's Office } ss.
Gogebic County }

For corners in Gogebic (County)

Located In: Corner Code #

1. Public Land Survey Section 9 T 47N R 47W E-4
   T ____ R ____
   T ____ R ____
   T ____ R ____
2. Property Controlling in Section S ____ T ____ R ____
   S ____ T ____ R ____
3. Miscellaneous Property in Sec. S ____ T ____ R ____
   S ____ T ____ R ____

Received for record the 30TH day of December A. D. 19 93 at 12:20 o'clock P m., and recorded in Liber 4 of Corners on page 328

Betty Lewis Deputy
Register of Deeds

Register of Deeds Stamp & File Number

4. Lot No. _____, Recorded Plat _____
5. Private Claims _____

1/4 CORNER COMMON TO SECTIONS 8&9, T47N, R47W

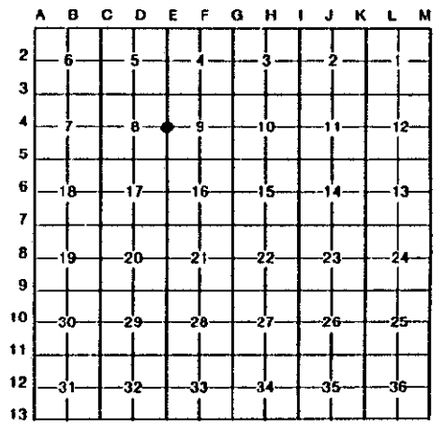

I, John R. Garske, in a field survey on December 22 93, 19 ____, do hereby certify that under requirements of P.A. 74, Michigan P.A. of 1970, the corner points mentioned in lines 1 and 2 above were in conformance with regulations and rules therefore as required in the current manual of survey instructions of the United States Department of the Interior, Bureau of Land Management or by a decree of a Court of Law and/or that the corner points mentioned in lines 3, 4 and 5 above were in conformance with the rules of the Michigan Board of Land Surveyors or by a Decree of a Court of Law; established, re-established, monumented, re-monumented, recovered, found as expressed below:

NOTE: Not more than 4 corners, all in the same town and range, may be recorded on this certificate.

A. Description of original monument and accessories and/or subsequent restoration:

Original survey by William Ives, Deputy Surveyor, in 1848. Original corner was a wood post and original bearing trees are:

Sugar 14" - S38°W - 35 links (23.1 feet)
B. oak 26" - N12°E - 31 links (20.46 feet)

B. Description of corner evidence found and/or method applied in restoring or reestablishing corner:

Found a P.K. nail marking corner position at the centerline of Nylund Road and its intersection with an ancient fence line running east and west. This corner position has been used in several surveys of record and is generally accepted as the one-quarter corner by area residents and the County Road Commission.

I am accepting this corner position as the most probable location of the true one-quarter corner.

C. Description of monument for corner and accessories established to perpetuate locating the position of the corner:

Set an 8" cotton spike (1/2" diameter hardened steel tapered to a point) at the P.K. nail from which I established:

Two reference monuments, 2 1/2" x 30" long aluminum monuments with 3 1/2" diameter aluminum caps stamped to identify the R.M.'s and corner location as follows:
1-Reference monument S52°W - 31.70 feet, 1.11 feet to steel sign post
2-Reference monument - N40°W - 38.60 feet, 1.00 feet to steel sign post
3-8" basswood - N40°E - 52.65 feet
4-12" basswood in a clump - S89°E - 43.00 feet

STATE OF MICHIGAN JOHN R. GARSKE LAND SURVEYOR No. 28410 LICENSED LAND SURVEYOR

Signed by John R Garske Date 12/23/93

Surveyor's Michigan License No. 28410

FORM APPROVED BY MICHIGAN STATE BOARD OF LAND SURVEYORS JAN. 26, 1971 REVISED MAY 14, 1975 REVISED JAN., 1983

FED: G-9