

LAND CORNER RECORDATION CERTIFICATE
Filing Requirement of Act 74, Mich. P.A. 1970

Register's Office }
 Gogebic County } ss.

For corners in
Gogebic
 (County)

Located In: Corner Code #

1. Public Land Survey	T <u>47N</u> R <u>47W</u>	<u>F-5</u>
	T _____ R _____	_____
	T _____ R _____	_____
	T _____ R _____	_____
2. Property Controlling	S _____ T _____ R _____	_____
in Section	S _____ T _____ R _____	_____
3. Miscellaneous	S _____ T _____ R _____	_____
Property in Sec.	S _____ T _____ R _____	_____

Received for record the
19th day of AUGUST
 A. D. 1994 at 1:15 o'clock
P m., and recorded in
 Liber 5 of CORNERS
 on page 81.
Ramona Collins, Deputy
 Register of Deeds

Register of Deeds Stamp & File Number

4. Lot No. _____, Recorded Plat _____
 5. Private Claims _____

	A	B	C	D	E	F	G	H	I	J	K	L	M
2	6	5	4	3	2								
3													
4	7	8	9	10	11	12							
5													
6	18	17	16	15	14	13							
7													
8	19	20	21	22	23	24							
9													
10	30	29	28	27	26	25							
11													
12	31	32	33	34	35	36							

I, John R. Garske, in a field survey on May 16, 1994, do hereby certify that under requirements of P.A. 74, Michigan P.A. of 1970, the corner points mentioned in lines 1 and 2 above were in conformance with regulations and rules therefore as required in the current manual of survey instructions of the United States Department of the Interior, Bureau of Land Management or by a decree of a Court of Law and/or that the corner points mentioned in lines 3, 4 and 5 above were in conformance with the rules of the Michigan Board of Land Surveyors or by a Decree of a Court of Law; established, re-established, monumented, re-monumented, recovered, found as expressed below:

NOTE: Not more than 4 corners, all in the same town and range, may be recorded on this certificate.

A. Description of original monument and accessories and/or subsequent restoration:

Original survey by William Ives in 1848. Set a post. Original Bearing Trees:
 6" sugar - N20°E - 2 links; 8" sugar - S60°E - 25 links
 1978 survey by Ewart C. Muller, RLS 15408. Set 1 1/2" x 5" iron pipe with brass cap and recorded in Liber 1 of Land Corners, pages 388 and 389. Accessories: 6" maple - N10°W - 37.40 feet; 12" maple - S54°E - 32.30 feet.

B. Description of corner evidence found and/or method applied in restoring or reestablishing corner:

I found a 1 1/2" iron pipe with an unstamped 2 1/4" brass cap at corner position which checks with Muller's witnesses to bearing trees, I found and noted in his certificate. I updated the corner monument and accessories as noted below to state and county specifications.

Act 74 research on file with County Register of Deeds Office.

PEER GROUP **Approved**


Richard P. Drake 8/17/94

(SEE SKETCH ON BACK)

C. Description of monument for corner and accessories established to perpetuate locating the position of the corner:

Stamped existing brass cap as follows: 1/4, S-9, S-16, T47N, R47W, 1994, RLS 28410. I established the following bearing trees and reference objects:

- 7" sugar - N10°W - 37.45 feet
- 6" sugar - S36°W - 0.41 feet
- 6" steel sign post - Due North - 1.25 feet
- Found 3/4" iron pipe - N64°W - 30.04 feet
- 12" sugar - S54°E - 32.31 feet
- 3" sugar - N35°E - 21.73 feet

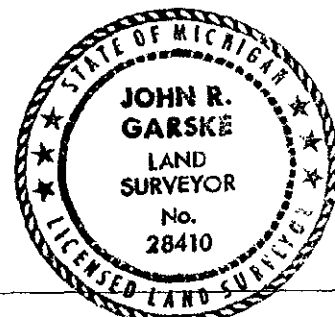

Signed by John R. Garske Date 6/10/94
 Surveyor's Michigan License No. 28410

1/4 COR. S-9&16
SKETCH

(B.T.) Existing 7" Sugar Maple

