

**LAND CORNER RECORDATION CERTIFICATE**  
**Filing Requirement of Act 74, Mich. P.A. 1970**

Register's Office }  
 Gogebic County } ss.

For corners in  
Gogebic  
 (County)

Located in: Corner Code #  
T47N R47W G-3

1. Public Land Survey  
 T    R     
 T    R     
 T    R   

2. Property Controlling in Section  
 S    T    R     
 S    T    R   

3. Miscellaneous Property in Sec.  
 S    T    R     
 S    T    R   

4. Lot No. \_\_\_\_\_, Recorded Plat \_\_\_\_\_

5. Private Claims \_\_\_\_\_


Section corner common to Sections 3, 4, 9, and 10

**SURVEY & MONUMENTATION**  
**JAN 05 2001**  
**SECTION**

Received for record the  
4<sup>TH</sup> day of DECEMBER  
 A. D. 1900 at 10:45 o'clock  
A m., and recorded in  
 Liber 8 of COGNATE  
 page 40  
Ramona L. Collins, Deputy  
 Register of Deeds  
 Register of Deeds Stamp & File Number

I, John R. Garske, in a field survey on October 16, 2000, do hereby state that under requirements of P.A. 74, Michigan P.A. of 1970, the corner points mentioned in lines 1 and 2 above were in conformance with regulations and rules therefore as required in the current manual of survey instructions of the United States Department of the Interior, Bureau of Land Management or by a decree of a Court of Law and / or that the corner points mentioned in lines 3, 4, and 5 above were in conformance with the rules of the Michigan Board of Land Surveyors or by a Decree of a Court of Law; established, re-established, monumented, recovered, found as expressed below.

NOTE: Not more than 4 corners, all in the same town and range, may be recorded on this certificate.

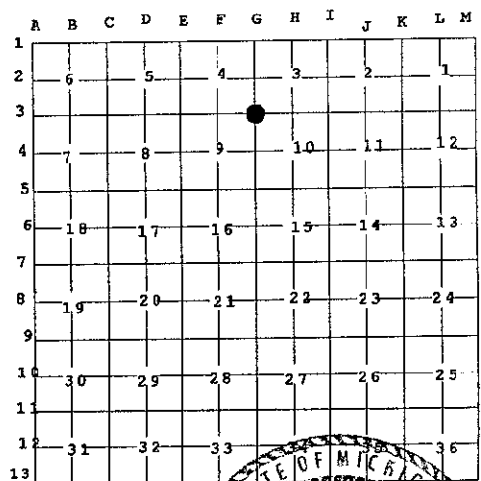

**A. Description of original monument and accessories and / or subsequent restoration:**

Original corner was set by William Ives in April of 1848  
 Set a wood post witnessed by the following:  
 10" Fir N48°E 22 links  
 12" Maple S34°W 28 links


1938 U.S.D.A. field notes appear to cross over corner position. The index makes reference, but no information is noted in their field books.

1972 survey by T. Nelson shows corner position but no precise ties.

1978 corner search by J. Goss, R.L.S., and J. Garske, R.L.S. searched at centerline of road and fence line intersection. A strong magnetic pull was observed and excavated road approximately one foot below road surface. Nothing found.

1980's - Various surveys of record within Section 10 - Section has been subdivided, however, the northwest corner of Section 10 has not been set.

1995 - Corner monumented by J. Garske, P.S. and recorded in Liber 5, page 282.

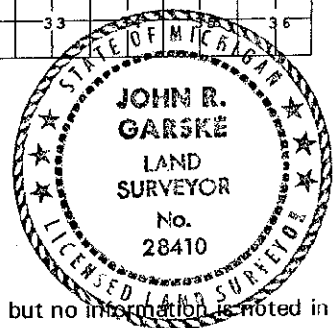

**B. Description of corner evidence found and / or method applied in restoring or re-establishing corner:**

The corner position was destroyed during road construction by the Gogebic County Road Commission. We offset the corner prior to removal and restored it in the original position after construction.

**C. Description of monument for corner and accessories established to perpetuate locating the position of the corner:**

I set a 3 1/4" diameter brass cap stamped, "T47N, R47W; S-4; S-5; S-9; D-10; 1995; RLS-28410", from which I established the following bearing trees and reference objects:

Power pole # 35		N15°E	121.34 feet (M)	121.48 feet (R)
20" Maple		N74°E	63.72 feet (M)	63.72 feet (R)
Power pole #324		N12°W	179.76 feet (M)	179.99 feet (R)
Witness Point #1	5/8" Rebar	N03°W	539.53 feet	New
Witness Point #2	5/8" Rebar	N03°W	789.52 feet	New
Reference Monument 1	3 1/2" x 30" Bernsten Mon.	N47°E	43.71 feet	Existing
Reference Monument 2	3 1/2" x 30" Bernsten Mon.	N52°W	44.52 feet	New

Signed by John R. Garske

Date 11-29-00

Surveyor's Michigan License No. 28410  
 FB # 251, page 37