



SKETCH
NO SCALE

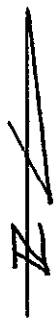

SURVEY &
REMONUMENTATION

SEP 29 1994

COMMISSION

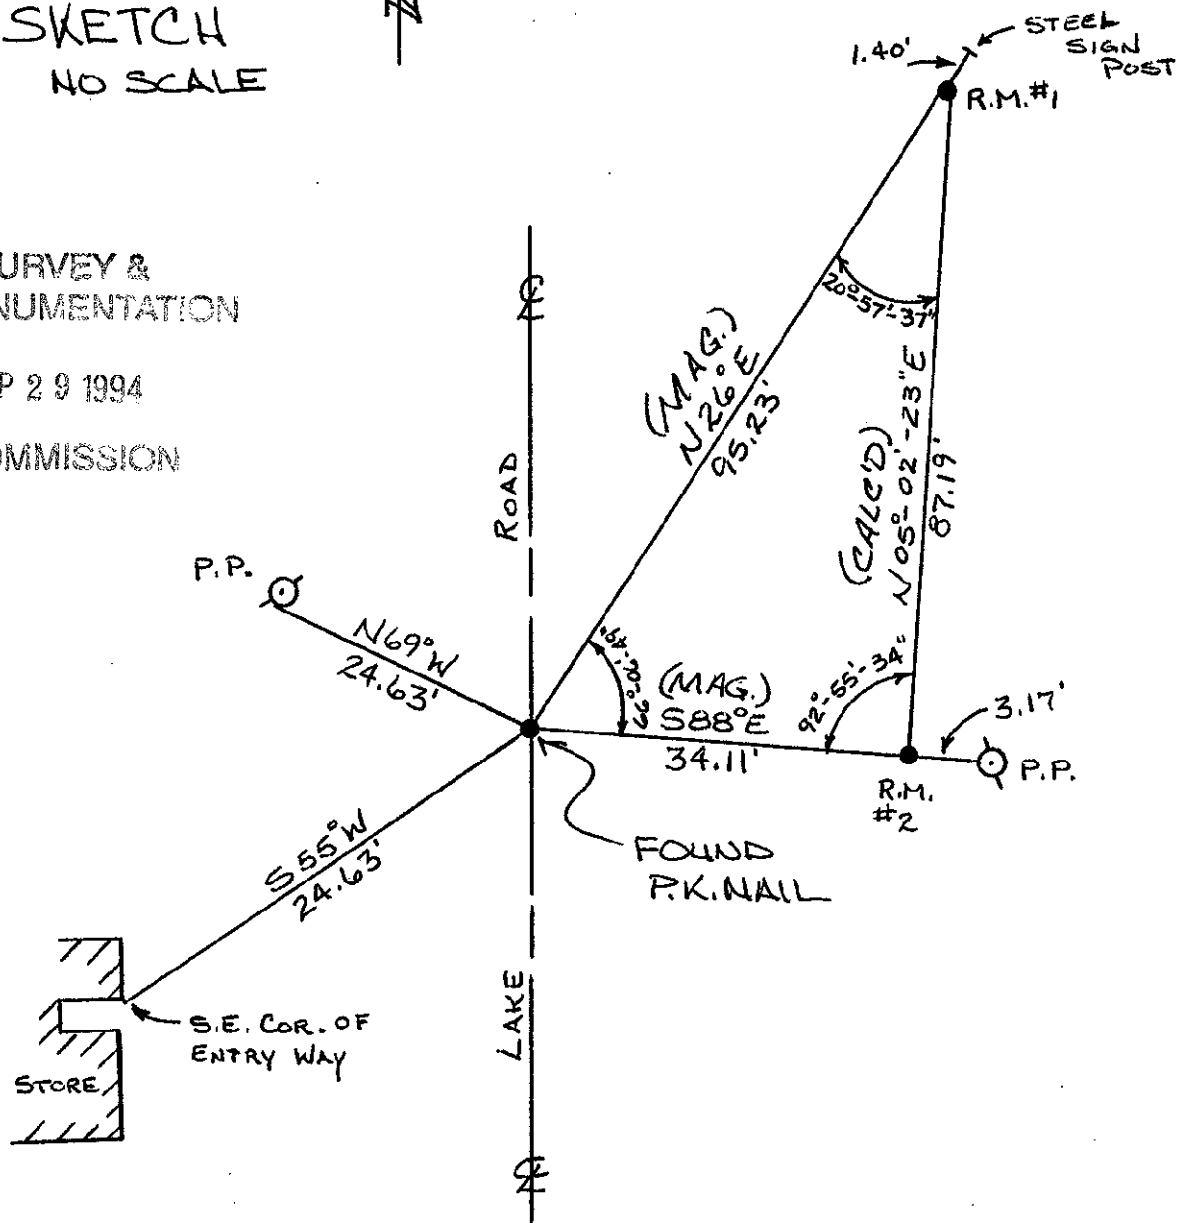

47-47, I-5