

**LAND CORNER RECORDATION CERTIFICATE**  
**Filing Requirement of Act 74, Mich. P.A. 1970**

Register's Office }  
 Gogebic County } ss.

Received for record the  
1994 day of August  
 A. D. 1994 at 1:20 o'clock  
P m., and recorded in  
 Liber 5 of COMMAS  
 on page 91  
*Ramona Collins, Deputy*  
 Register of Deeds

For corners in

Gogebic  
 (County)

Located In:

Corner Code #:

- |                                       |                           |            |
|---------------------------------------|---------------------------|------------|
| 1. Public Land Survey<br><u>S-22</u>  | T <u>47N</u> R <u>47W</u> | <u>I-8</u> |
|                                       | T _____ R _____           | _____      |
|                                       | T _____ R _____           | _____      |
|                                       | T _____ R _____           | _____      |
| 2. Property Controlling<br>in Section | S _____ T _____ R _____   | _____      |
|                                       | S _____ T _____ R _____   | _____      |
| 3. Miscellaneous<br>Property in Sec.  | S _____ T _____ R _____   | _____      |
|                                       | S _____ T _____ R _____   | _____      |

Register of Deeds Stamp & File Number

4. Lot No. \_\_\_\_\_, Recorded Plat \_\_\_\_\_  
 5. Private Claims \_\_\_\_\_

	A	B	C	D	E	F	G	H	I	J	K	L	M
2	6	5	4	3	2								
3													
4	7	8	9	10	11	12							
5													
6	18	17	16	15	14	13							
7													
8	19	20	21	22	23	24							
9													
10	30	29	28	27	26	25							
11													
12	31	32	33	34	35	36							
13													

I, John R. Garske, in a field survey on May 31, 1994, do hereby certify that under requirements of P.A. 74, Michigan P.A. of 1970, the corner points mentioned in lines 1 and 2 above were in conformance with regulations and rules therefore as required in the current manual of survey instructions of the United States Department of the Interior, Bureau of Land Management or by a decree of a Court of Law and/or that the corner points mentioned in lines 3, 4 and 5 above were in conformance with the rules of the Michigan Board of Land Surveyors or by a Decree of a Court of Law; established, re-established, monumented, re-monumented, recovered, found as expressed below:

**NOTE: Not more than 4 corners, all in the same town and range, may be recorded on this certificate.**

A. Description of original monument and accessories and/or subsequent restoration:

**Original survey by William Ives in 1848. Set post, original bearing trees: 10" sugar - S22°W - 24 links; 8" fir - N33°E - 29 links.**

**1927 recorded Plat of Assessor's No. 3 to the City of Ironwood - Concrete monument in middle of street.**

**1990 survey by John R. Garske, RLS 28410. Re-established corner from found plat corners within Assessor's No. 3 as recorded in Liber 2 of Land Corners, page 722, accessories noted below.**

B. Description of corner evidence found and/or method applied in restoring or reestablishing corner:

**I found a large P.K. nail at corner position, which checks with certificate noted above. I updated the corner monument and accessories as noted below to state and county specifications. All accessories in L.C.R.C. by Garske are in good condition and are noted below with additional accessories.**

**Act 74 research on file with County Register of Deeds Office.**

**PEER GROUP**

**Approved**


*Richard L. Deah* 8/17/94

**(SEE SKETCH ON BACK)**

C. Description of monument for corner and accessories established to perpetuate locating the position of the corner:

**I replaced found P.K. nail with a 2 1/2" brass cap set in rockite mortar. Brass cap is stamped: 1/4, S-22, S-23, T47N, R47W, 1994, RLS 28410. I established the following reference objects: Reference monument consisting of a 2 1/2" x 30" aluminum pipe with a 3 1/4" aluminum cap stamped to indicate corner position - N60°E - 38.42 feet with steel sign post - N78°W - 0.97 feet**

- S.E. corner foundation House No. 741 Sutherland Ave. - N52°W - 89.39 feet.**
- Power pole #21-1-90/06 - N88°W - 129.19 feet**
- Power pole #23-2-7/07 - N87°E - 23.67 feet**
- 5/8" x 20" rebar w/cap - Due West - 30.00 feet.**

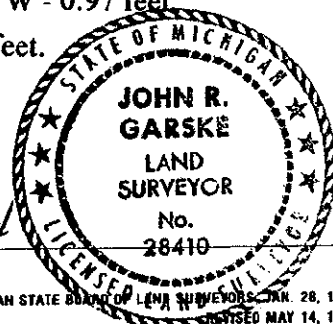

Signed by John R. Garske Date 6/10/94  
 Surveyor's Michigan License No. 28410

SKETCH

