

SURVEY & REMONUMENTATION

SEP 29 1994

LAND CORNER RECORDATION CERTIFICATE
Filing Requirement of Act 74, Mich. P.A. 1970

For corners in COMMISSION
Gogebic
(County)

	Located In:	Corner Code #
1. Public Land Survey	T <u>47N</u> R <u>47W</u>	<u>I-11</u>
	T _____ R _____	_____
	T _____ R _____	_____
	T _____ R _____	_____
2. Property Controlling in Section	S _____ T _____ R _____	_____
	S _____ T _____ R _____	_____
3. Miscellaneous Property in Sec.	S _____ T _____ R _____	_____
	S _____ T _____ R _____	_____
4. Lot No. _____, Recorded Plat _____		
5. Private Claims _____		

Register's Office }
Gogebic County } ss.

Received for record the
16 day of SEPT
A. D. 1994 at 4:10 o'clock
P m., and recorded in
Liber 5 of CORNERS
on page 133
Raymond Collins, Deputy
Register of Deeds

Register of Deeds Stamp & File Number

Section corner common to Sections 26, 27, 34 & 35

I, John R. Garske, in a field survey on July, 19 94, do hereby certify that under requirements of P.A. 74, Michigan P.A. of 1970, the corner points mentioned in lines 1 and 2 above were in conformance with regulations and rules therefore as required in the current manual of survey instructions of the United States Department of the Interior, Bureau of Land Management or by a decree of a Court of Law and/or that the corner points mentioned in lines 3, 4 and 5 above were in conformance with the rules of the Michigan Board of Land Surveyors or by a Decree of a Court of Law; established, re-established, monumented, re-monumented, recovered, found as expressed below:

	A	B	C	D	E	F	G	H	I	J	K	L	M
2	6	5	4	3	2	1							
3													
4	7	8	9	10	11	12							
5													
6	18	17	16	15	14	13							
7													
8	19	20	21	22	23	24							
9													
10	30	29	28	27	26	25							
11													
12	31	32	33	34	35	36							
13													

NOTE: Not more than 4 corners, all in the same town and range, may be recorded on this certificate.

A. Description of original monument and accessories and/or subsequent restoration:

Original survey by William Ives, D.S., in 1848. Set wood post. Original bearing trees: Sugar 9" - N69°E, 17 links; cedar 10" - S32°W, 7 links.

The corner position was found by John P. Goss, RLS 23509, in July 1979 consisting of a one-half inch rebar. He recorded the corner in liber 1 of land corners P. 484. Accessories: P. pole - N47°E, 53.57'; N. pine 13" - S60°E, 67.89'; Spruce 6" - S36°W, 72.55'.

B. Description of corner evidence found and/or method applied in restoring or reestablishing corner:

I re-established the corner from witnesses on Goss' recordation certificate and updated the corner as noted below to bring it up to county and state specifications.

Act 74 research on file with County Register of Deeds Office.

PEER GROUP

Approved

Richard P. Orahn


9/14/94

C. Description of monument for corner and accessories established to perpetuate locating the position of the corner:

I set a cotton gin spike and established the following bearing trees and reference objects: Two reference monuments consisting of a 2 1/2" x 30" aluminum pipe with a 3 1/4" aluminum cap stamped to indicate the corner position as follows: R.M. #1 - N01°E, 29.57 feet - with steel sign post 1.60' away; R.M. #2 - S35°E, 54.02 feet - with steel sign post 1.69' away; existing P. pole - N47°E, 53.57 feet; R. pine 14" - S60°E, 68.19 feet; Spruce 10" - S36°W, 72.59 feet.

SEE SKETCH ON BACK

Signed by John R. Garske Date 8/29/94
Surveyor's Michigan License No. 28410

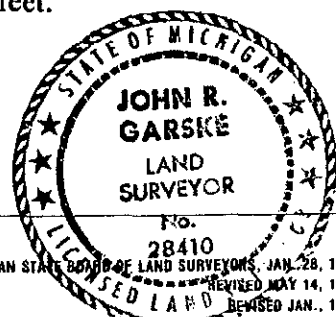

SKETCH
NO SCALE



47-47 - I-11

SURVEY &
REMONUMENTATION

SEP 29 1984

COMMISSION

