SURVEY &
REMONUMENTATION

SEP 29 1994

COMMISSION

LAND CORNER RECORDATION CERTIFICATE

Filing Requirement of Act 74, Mich. P.A. 1970

Register's Office } ss.
Gogebic County }

Received for record the 16 day of SEPT A. D. 1994 at 4:10 o'clock P m., and recorded in Liber 5 of CORNERS on page 138.

Ramona Collins Deputy
Register of Deeds

Register of Deeds Stamp & File Number

For corners in Gogebic (County)

	Located In:	Corner Code ##
1. Public Land Survey	T 47N R 47W	I-13
	T ___ R ___	
	T ___ R ___	
	T ___ R ___	
2. Property Controlling	S ___ T ___ R ___	
in Section	S ___ T ___ R ___	
3. *Miscellaneous*	S ___ T ___ R ___	
Property in Sec.	S ___ T ___ R ___	

4. Lot No. _____ , Recorded Plat _____
5. Private Claims _____

Section corner common to Sections 34 & 35, T47N, R47W and Sections 2 & 3, T46N, R47W.

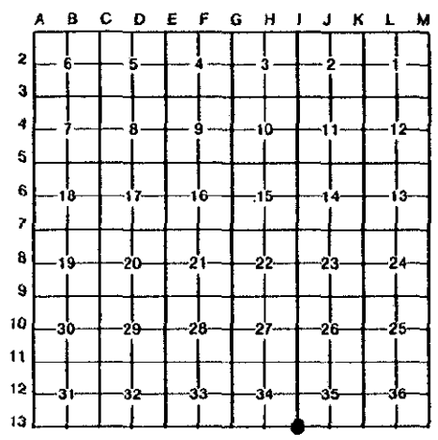

I, John R. Garske, in a field survey on June 15, 19 94, do hereby certify that under requirements of P.A. 74, Michigan P.A. of 1970, the corner points mentioned in lines 1 and 2 above were in conformance with regulations and rules therefore as required in the current manual of survey instructions of the United States Department of the Interior, Bureau of Land Management or by a decree of a Court of Law and/or that the corner points mentioned in lines 3, 4 and 5 above were in conformance with the rules of the Michigan Board of Land Surveyors or by a Decree of a Court of Law; established, re-established, monumented, re-monumented, recovered, found as expressed below:

NOTE: Not more than 4 corners, all in the same town and range, may be recorded on this certificate.

A. Description of original monument and accessories and/or subsequent restoration:

- Original survey by William A. Burt, D.S., in 1847. Set cedar post. Original bearing trees: Cedar 10" - N32°E, 30 links; cedar 10" - N29°W, 52 links. Bearing trees set by William Ives, D.S., in 1848; Cedar 12" - S67°W, 43 links; cedar 10" - S47°E, 20 links.

- 1991 survey for the City of Ironwood by John Garske, P.S. Set a 3/4" rebar with an aluminum cap. Accessories: chiseled mark on side of west gate rail - S40°W, 58.73 feet; 1" iron pipe set at base of "curve arrow" road sign - S82°E, 27.73 feet.

B. Description of corner evidence found and/or method applied in restoring or reestablishing corner:

Found aluminum capped rebar as noted above. Corner was set on the centerline extensions of Pioneer Road and Riverside Road and an ancient fence line to the south. I updated corner as noted below to bring it up to county and state specifications.

Research record form on file with County Register of Deeds Office.

PEER GROUP **Approved**

Richard L. Drahn 9/14/94

STATE OF MICHIGAN
JOHN R. GARSKE
LAND SURVEYOR
No. 28410
LICENSED LAND SURVEYOR

C. Description of monument for corner and accessories established to perpetuate locating the position of the corner:

I set a 3/4" x 30" rebar with a 3 1/4" stamped aluminum cap at the corner location 6-8" below gravel road surface. The cap is stamped S-34, S-35, S-2, S-3, T46-47N, R47W, 1994, RLS 28410. I established the following bearing trees and reference objects: A reference monument consisting of a 2 1/2" x 30" aluminum pipe with a 3 1/4" aluminum cap stamped to indicate the corner position as follows: R.M. - N32°W, 48.11 feet with a steel sign post 1.50 feet away; existing 1" iron pipe set at base of curve arrow road sign - S82°E, 27.73 feet; existing chisel mark in west gate post - S40°W, 58.73 feet; R. pine 10" - S64°E, 71.81 feet; steel sign post - Due South, 3.80 feet.

Signed by John R Garske Date 8/31/94

Surveyor's Michigan License No. 28410

FORM APPROVED BY MICHIGAN STATE BOARD OF LAND SURVEYORS, JAN. 28, 1971
REVISED MAY 14, 1976
REVISED JAN., 1983

FED No. Z-17 120