

SURVEY & REMONUMENTATION

SEP 29 1994

COMMISSION

LAND CORNER RECORDATION CERTIFICATE
Filing Requirement of Act 74, Mich. P.A. 1970

For corners in

Gogebic

(County)

Located In:

Corner Code #

- | | | | | | |
|---------------------------------------|---|------------|---|------------|------------|
| 1. Public Land Survey | T | <u>47N</u> | R | <u>47W</u> | <u>J-3</u> |
| | T | _____ | R | _____ | _____ |
| | T | _____ | R | _____ | _____ |
| | T | _____ | R | _____ | _____ |
| 2. Property Controlling in Section | S | _____ | T | _____ | _____ |
| | S | _____ | T | _____ | _____ |
| 3. Miscellaneous Property in Sec. | S | _____ | T | _____ | _____ |
| | S | _____ | T | _____ | _____ |
| 4. Lot No. _____, Recorded Plat _____ | | | | | |
| 5. Private Claims _____ | | | | | |

Register's Office } ss.
Gogebic County }

Received for record the
16TH day of SEPT.

A. D. 1994 at 3:50 o'clock
P m., and recorded in

Liber 5 of CORNER
on page 109.

Ramona Collins, Deputy
Register of Deeds

Register of Deeds Stamp & File Number

One-quarter corner common to Sections 2 & 11, T47N, R47W.

I, John R. Garske, in a field survey on June 20, 19 94, do hereby certify that under requirements of P.A. 74, Michigan P.A. of 1970, the corner points mentioned in lines 1 and 2 above were in conformance with regulations and rules therefore as required in the current manual of survey instructions of the United States Department of the Interior, Bureau of Land Management or by a decree of a Court of Law and/or that the corner points mentioned in lines 3, 4 and 5 above were in conformance with the rules of the Michigan Board of Land Surveyors or by a Decree of a Court of Law; established, re-established, monumented, re-monumented, recovered, found as expressed below:

NOTE: Not more than 4 corners, all in the same town and range, may be recorded on this certificate.

A. Description of original monument and accessories and/or subsequent restoration:

- On August 28, 1848, William Ives set quarter section post from which a sugar 8" bears S27°E, 35 links and a sugar 7" - N25°W, 35 links.
- August 1938 survey by the U.S.D.A., set a 5" x 42" concrete monument from which the S.E. corner of house - N.W.ly, 65.87 feet and N.E. corner of house - S.W.ly, 61.96 feet.
- June 1982, survey by J.R. Garske, RLS 28410, restored corner from U.S.D.A. witness. Set nail in pavement over concrete monument. Reused accessories from 1938 U.S.D.A. notes and recorded on Liber 2, P. 266.

B. Description of corner evidence found and/or method applied in restoring or reestablishing corner:

Found nail marking the corner location which checks with witnesses from my previous recordation certificate and updated the corner as noted below to bring it up to county and state specifications.

Act 74 research on file with County Register of Deeds Office.

FEER GROUP

Approved

Richard E. Dredin

9/14/94

A	B	C	D	E	F	G	H	I	J	K	L	M
2	6	5	4	3	2							
3												
4	7	8	9	10	11	12						
5												
6	18	17	16	15	14	13						
7												
8	19	20	21	22	23	24						
9												
10	30	29	28	27	26	25						
11												
12	31	32	33	34	35	36						
13												

C. Description of monument for corner and accessories established to perpetuate locating the position of the corner:

I replaced the found nail with a 2 1/2" brass cap with a 2" stem set in anchoring cement. Brass cap is stamped: S-2; S-11; T47N, R47W; 1/4; 1994; RLS 28410. I established the following reference objects and bearing trees: A reference monument consisting of a 2 1/2" x 30" aluminum pipe with a 3" aluminum cap stamped to indicate the corner position as follows: S38°W - 28.00 feet with steel sign post 1.45 feet away; P. pole #22 - S08°W, 31.66 feet; top of hydrant - S64°W, 81.20 feet; 21" R. maple - N53°W, 54.62 feet.

Signed by


John R. Garske

Date

8/30/94

Surveyor's Michigan License No.

28410

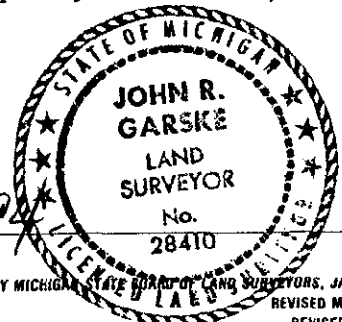

FORM APPROVED BY MICHIGAN STATE BOARD OF LAND SURVEYORS, JAN. 28, 1971
REVISED MAY 14, 1975
REVISED JAN., 1983