

LAND CORNER RECORDATION CERTIFICATE
Filing Requirement of Act 74, Mich. P.A. 1970

Register's Office } ss.
 Gogebic County }

Received for record the
19th day of AUGUST
 A. D. 1994 at 1:15 o'clock
P m., and recorded in
 Liber 5 of CORNERS
 on page 83.
Ramona Collins, Deputy
 Register of Deeds

For corners in

Gogebic
 (County)

Located In:

Corner Code #

1. Public Land Survey	T	<u>47N</u>	R	<u>47W</u>	<u>J-5</u>
	T	_____	R	_____	_____
	T	_____	R	_____	_____
	T	_____	R	_____	_____
2. Property Controlling in Section	S	_____	T	_____	_____
	S	_____	T	_____	_____
3. Miscellaneous Property in Sec.	S	_____	T	_____	_____
	S	_____	T	_____	_____

Register of Deeds Stamp & File Number

4. Lot No. _____, Recorded Plat _____
 5. Private Claims _____

A	B	C	D	E	F	G	H	I	J	K	L	M
2	6	5	4	3	2	1						
3												
4	7	8	9	10	11	12						
5												
6	18	17	16	15	14	13						
7												
8	19	20	21	22	23	24						
9												
10	30	29	28	27	26	25						
11												
12	31	32	33	34	35	36						
13												

I, John R. Garske, in a field survey on May 5, 1994, do hereby certify that under requirements of P.A. 74, Michigan P.A. of 1970, the corner points mentioned in lines 1 and 2 above were in conformance with regulations and rules therefore as required in the current manual of survey instructions of the United States Department of the Interior, Bureau of Land Management or by a decree of a Court of Law and/or that the corner points mentioned in lines 3, 4 and 5 above were in conformance with the rules of the Michigan Board of Land Surveyors or by a Decree of a Court of Law; established, re-established, monumented, re-monumented, recovered, found as expressed below:

NOTE: Not more than 4 corners, all in the same town and range, may be recorded on this certificate.

A. Description of original monument and accessories and/or subsequent restoration:

Original survey by William Ives in 1848, set post. Original Bearing Trees:
 Oak 6" - S80°E - 23 links; Y. birch 12" - N26°W, 5 links
 Survey by U.S.D.A. in 1938, set concrete monument. Bearing trees: 8" maple - N20°E - 39.90 feet; 14" twin maple - N88°W - 79.98 feet; 6" maple - N01°W - 43.77 feet.
 Survey by Ewart C. Muller, RLS 15408, on June 25, 1979. Set 48" concrete monument from which a 18" maple - N68°W - 13.98 feet and a 4" oak - N14°E - 36.89 feet, recorded in Liber 1 of Land Corners, page 494.

B. Description of corner evidence found and/or method applied in restoring or reestablishing corner:


I found a 4" diameter x 48" long concrete monument marking the corner position which checks with Mullers certificate as noted above. I updated the corner monument and accessories as noted below to bring them up to state and county specifications.

Act 74 research on file with County Register of Deeds Office.

PEER GROUP

Approved


Richard J. Orsini 8/17/94

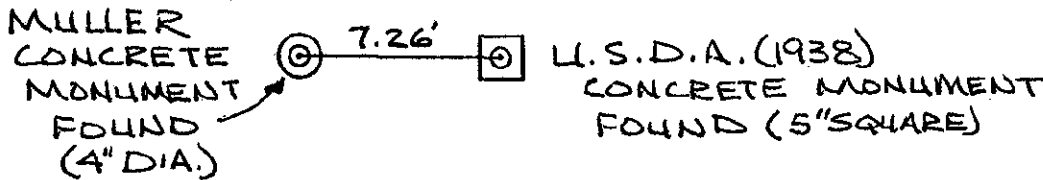

C. Description of monument for corner and accessories established to perpetuate locating the position of the corner:

Set a 3 1/4" aluminum cap on the found 4" diameter concrete monument with a 1/2" iron pin, cap is stamped: 1/4, S-11, S-14, T47N, R47W, 1994, RLS 28410. Established the following bearing trees and reference objects:

- Steel sign post - N30°W - 1.46 feet
- 18" maple - N86°W - 14.39 feet
- 4" oak - N15°E - 36.92 feet
- 4" S. maple - S35°E - 13.31 feet

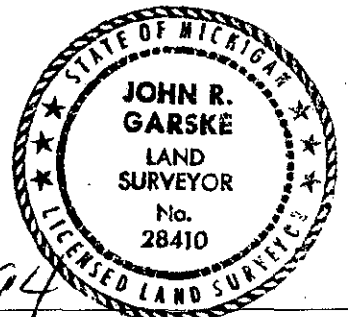

Signed by John R. Garske
 Surveyor's Michigan License No. 28410

Date 6/10/94