

REGISTERED &
RECORD REGISTRATION
FEB 18 1994
COMMISSION

LAND CORNER RECORDATION CERTIFICATE
Filing Requirement of Act 74, Mich. P.A. 1970

Register's Office }
Gogebic County } ss.

Received for record the
30th day of DECEMBER
A. D. 1993 at 12:30 o'clock
P m., and recorded in
Liber 4 of CORNERS
on page 332.
Betty Lorie Deputy
Register of Deeds

For corners in Gogebic (County) Located In: Corner Code ##

1. Public Land Survey	T <u>47N</u> R <u>47W</u>	<u>K-2</u>
	T _____ R _____	_____
	T _____ R _____	_____
	T _____ R _____	_____
2. Property Controlling in Section	S _____ T _____ R _____	_____
	S _____ T _____ R _____	_____
3. Miscellaneous Property in Sec.	S _____ T _____ R _____	_____
	S _____ T _____ R _____	_____

Register of Deeds Stamp & File Number

4. Lot No. _____, Recorded Plat _____
5. Private Claims _____
One-quarter corner S-1 & 2, T47N, R47W.

	A	B	C	D	E	F	G	H	I	J	K	L	M
2	6	5	4	3	2	1							
3													
4	7	8	9	10	11	12							
5													
6	10	17	16	15	14	13							
7													
8	19	20	21	22	23	24							
9													
10	30	29	28	27	26	25							
11													
12	31	32	33	34	35	36							

I, John R. Garske, in a field survey on December 13, 1993, do hereby certify that under requirements of P.A. 74, Michigan P.A. of 1970, the corner points mentioned in lines 1 and 2 above were in conformance with regulations and rules therefore as required in the current manual of survey instructions of the United States Department of the Interior, Bureau of Land Management or by a decree of a Court of Law and/or that the corner points mentioned in lines 3, 4 and 5 above were in conformance with the rules of the Michigan Board of Land Surveyors or by a Decree of a Court of Law; established, re-established, monumented, re-monumented, recovered, found as expressed below:

NOTE: Not more than 4 corners, all in the same town and range, may be recorded on this certificate.

A. Description of original monument and accessories and/or subsequent restoration:

William Ives, U.S.D.S., August 25, 1848. Set wood post from which a 12" Y. birch bears N27°E, 15 links and a 10" hemlock bears S31°W, 28 links.

B. Description of corner evidence found and/or method applied in restoring or reestablishing corner:

Found a 5" x 42" concrete monument with a brass cap stamped: USDA; 1/4; S-2; S-1; T47N, R47W; 1938.


- Found 18" maple (2"-1938) SW'ly - 14.39 feet
- Found 14" basswood (6"-1938) NW'ly - 8.89 feet
- Found 12" basswood stub - north - 6.54 feet

This monument was set in 1938 by USDA surveyors at the west side of an old N-S rock fence. The corner has been used and accepted in many surveys and is setting harmoniously with all area residents.

C. Description of monument for corner and accessories established to perpetuate locating the position of the corner:

Accepted USDA brass capped monument as being true one-quarter corner. Established the following bearing trees and reference objects:

- 5" twin maple - S40°E - 14.24 feet
- 18" maple (USDA) - S22°W - 14.74 feet
- 14" basswood (USDA) - N53°W - 8.41 feet
- Steel sign post - north - 2.50 feet

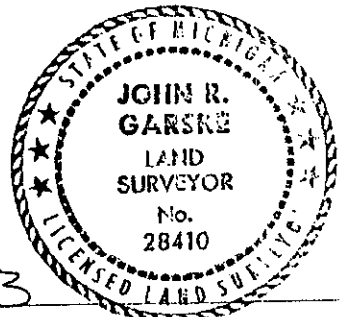

Signed by John R. Garske Date 12/20/93
Surveyor's Michigan License No. 28410