

LAND CORNER RECORDATION CERTIFICATE
Filing Requirement of Act 74, Mich. P.A. 1970

Register's Office }
 Gogebic County } ss.

Received for record the
15TH day of DECEMBER
 A. D. 1995 at 10:15 o'clock
A m., and recorded in
 Liber 5 of CORNERS
 on page 310.
Romona Collins, Deputy
 Register of Deeds

For corners in

Gogebic
(County)

Located In:

Corner Code #

1. Public Land Survey Sec. 14 T 47N R 47W
 T _____ R _____
 T _____ R _____
 T _____ R _____
2. Property Controlling S _____ T _____ R _____
 in Section S _____ T _____ R _____
3. Miscellaneous S _____ T _____ R _____
 Property in Sec. S _____ T _____ R _____

K-6

Seg. #2

Register of Deeds Stamp & File Number

4. Lot No. _____, Recorded Plat _____
 5. Private Claims _____

One-quarter corner common to Sections 13 & 14

I, John P. Goss, in a field survey on October 26, 1995, do hereby certify that under requirements of P.A. 74, Michigan P.A. of 1970, the corner points mentioned in lines 1 and 2 above were in conformance with regulations and rules therefore as required in the current manual of survey instructions of the United States Department of the Interior, Bureau of Land Management or by a decree of a Court of Law and/or that the corner points mentioned in lines 3, 4 and 5 above were in conformance with the rules of the Michigan Board of Land Surveyors or by a Decree of a Court of Law, established, re-established, monumented, re-monumented, recovered, found as expressed below:

	A	B	C	D	E	F	G	H	I	J	K	L	M
2	6		5		4		3		2		1		
3													
4	7		8		9		10		11		12		
5													
6	18		17		16		15		14		13		
7													
8	19		20		21		22		23		24		
9													
10	30		29		28		27		26		25		
11													
12	31		32		33		34		35		36		
13													

NOTE: Not more than 4 corners, all in the same town and range, may be recorded on this certificate.

A. Description of original monument and accessories and/or subsequent restoration:

In 1848, William Ives establish this corner with the following bearing trees: Cedar 3" N42°E-03 links and Cedar 3"- N65°W- 11 links.
 This corner was found in July of 1977 and recorded by Ewart C. Muller in Liber 1 of land corners on page 326.
 Accessories: P.Pole-N40°W-35.13'; P.Pole-N47°E-41.84'; P.Pole-S46°E-43.21'
 John R. Garski re-recorded this corner in 1994: Accessories: 2 reference monument consisting of 2½" x 30" aluminum pipe and 3¼" aluminum cap stamped to note corner position as follows:
 R.M. #1- N37°W-48.57' with steel sign post 0.90' away; R.M. #2- S36°W-43.51' with a steel sign post 0.93' away; Guy Post-S44°E-43.16'; P.Pole-N53°E- 41.73'.

B. Description of corner evidence found and/or method applied in restoring or reestablishing corner:

I found a P.K. Nail marking the corner position which checks with Garski witnesses in his certification. I updated the accessories as noted below to state and county spectification.


Act 74 reseach on file with County Register of Deeds Office.

C. Description of monument for corner and accessories established to perpetuate locating the position of the corner:

Set a 3/4" by 30" iron pin inside monument box at corner location. I established the following bearing trees and reference objects.
 Reference monument consisting of 2½" by 30" aluminum pipe with 3¼" aluminum cap stamped to indicated corner position.
 R. M. #1 N37°W-48.57'-steel sign post- 0.90 feet
 R. M. #2 S36°W-43.51'-steel sign post- 0.93 feet
 Guy Post #13-8/49- S44°E- 43.16 feet
 P.Pole #103- N53°E- 41.73 feet.

PEER GROUP APPROVED

Richard B. Drahm 12/14/95
 COUNTY REPRESENTATIVE

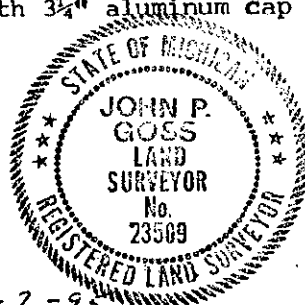

Signed by John P. Goss
 Surveyor's Michigan License No. 23509

Date 11-7-95

Gogebic County Road Commission