

**LAND CORNER RECORDATION CERTIFICATE**  
**Filing Requirement of Act 74, Mich. P.A. 1970**

Register's Office }  
 Gogebic County } ss.

For corners in Gogebic  
 (County)

Located In: \_\_\_\_\_ Corner Code # K-7

Received for record the  
19<sup>th</sup> day of AUGUST

A. D. 1994 at 1:20 o'clock

8 m., and recorded in  
 Liber 5 of CORNERS

on page 89.

Ramona Collins, Deputy  
 Register of Deeds

Register of Deeds Stamp & File Number

1. Public Land Survey Section 23 T 47N R 47W \_\_\_\_\_  
     T \_\_\_\_\_ R \_\_\_\_\_  
     T \_\_\_\_\_ R \_\_\_\_\_  
     T \_\_\_\_\_ R \_\_\_\_\_
2. Property Controlling S \_\_\_\_\_ T \_\_\_\_\_ R \_\_\_\_\_  
 in Section S \_\_\_\_\_ T \_\_\_\_\_ R \_\_\_\_\_
3. Miscellaneous S \_\_\_\_\_ T \_\_\_\_\_ R \_\_\_\_\_  
 Property in Sec. S \_\_\_\_\_ T \_\_\_\_\_ R \_\_\_\_\_
4. Lot No. \_\_\_\_\_, Recorded Plat \_\_\_\_\_
5. Private Claims \_\_\_\_\_

	A	B	C	D	E	F	G	H	I	J	K	L	M
2	6	5	4	3	2	1							
3													
4	7	8	9	10	11	12							
5													
6	18	17	16	15	14	13							
7													
8	19	20	21	22	23	24							
9													
10	30	29	28	27	26	25							
11													
12	31	32	33	34	35	36							
13													

I, John R. Garske, in a field survey on April 18, 19 94, do hereby certify that under requirements of P.A. 74, Michigan P.A. of 1970, the corner points mentioned in lines 1 and 2 above were in conformance with regulations and rules therefore as required in the current manual of survey instructions of the United States Department of the Interior, Bureau of Land Management or by a decree of a Court of Law and/or that the corner points mentioned in lines 3, 4 and 5 above were in conformance with the rules of the Michigan Board of Land Surveyors or by a Decree of a Court of Law, established, re-established, monumented, re-monumented, recovered, found as expressed below:

**NOTE: Not more than 4 corners, all in the same town and range, may be recorded on this certificate.**

A. Description of original monument and accessories and/or subsequent restoration:  
 Original survey by William Ives, D.S., in 1848.

Original Bearing Trees:

- Spruce - 10" - N26°W - 17 links
- Hemlock - 9" - S66°W - 25 links

The corner position was found by Ewart C. Muller, RLS 15408, in July of 1977 marked by a 5/8" diameter solid steel drill rod. He recorded the corner in Liber 1 of corners, page 345 and 346.

Accessories: 3" cherry - S60°E-72.93'; 8" Apple - S07°W-109.96'; N.E. Tower Leg - S56°W-53.19'.

B. Description of corner evidence found and/or method applied in restoring or reestablishing corner:

I found the 5/8" diameter rod used by Muller and updated the corner monument and accessories as noted below to bring them up to State and County specifications.

Act 74 research on file with County Register of Deeds Office.

**PEER GROUP**


**Approved**

Richard L. Decker 8/17/94

C. Description of monument for corner and accessories established to perpetuate locating the position of the corner:

I replaced the iron rod with a 2 1/2" diameter aluminum pipe x 30" long with a 3 1/4" diameter aluminum cap stamped: County Monument, T47N, R47W, S-14, S-13, S-23, S-24, 1994, RLS 28410, from which I established the following accessories:

- 6" cherry - S57°E - 72.93 feet
- 4" cherry - N14°E - 119.42 feet
- 6" pine - N23°W - 53.87 feet
- Northwest tower leg - S59°W - 53.19 feet

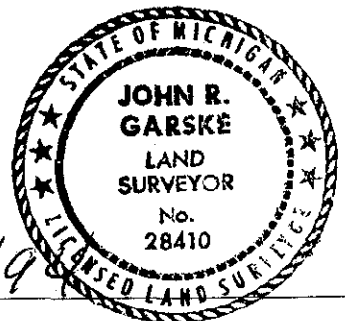

Signed by John R. Garske Date 6/19/94  
 Surveyor's Michigan License No. P.S. #28410