

SURVEY & REMONUMENTATION

JUN 29 1995

COMMISSION

LAND CORNER RECORDATION CERTIFICATE
Filing Requirement of Act 74, Mich. P.A. 1970

For corners in

_____ Gogebic _____ (County)	Located In:	Corner Code #
1. Public Land Survey	S-26 T <u>47N</u> R <u>47W</u>	<u>K-10</u>
	T _____ R _____	
	T _____ R _____	
	T _____ R _____	
2. Property Controlling in Section	S _____ T _____ R _____	
	S _____ T _____ R _____	
3. Miscellaneous Property in Sec.	S _____ T _____ R _____	
	S _____ T _____ R _____	
4. Lot No. _____, Recorded Plat _____		
5. Private Claims _____		

Register's Office }
Gogebic County } ss.

Received for record this
12th day of APRIL
A. D. 1995 at 1:15 o'clock
P m., and recorded in
Liber 5 of CORNERS
on page 234
Ramona Collins, Deputy
Register of Deeds

Register of Deeds Stamp & File Number

One-quarter corner common to Sections 26 and 25, T47N, R47W

I, John R. Garske, in a field survey on April 5, 19 95, do hereby certify that under requirements of P.A. 74, Michigan P.A. of 1970, the corner points mentioned in lines 1 and 2 above were in conformance with regulations and rules therefore as required in the current manual of survey instructions of the United States Department of the Interior, Bureau of Land Management or by a decree of a Court of Law and/or that the corner points mentioned in lines 3, 4 and 5 above were in conformance with the rules of the Michigan Board of Land Surveyors or by a Decree of a Court of Law; established, re-established, monumented, re-monumented, recovered, found as expressed below:

A	B	C	D	E	F	G	H	I	J	K	L	M
2	6	5	4	3	2	1						
3												
4	7	8	9	10	11	12						
5												
6	18	17	16	15	14	13						
7												
8	19	20	21	22	23	24						
9												
10	30	29	28	27	26	25						
11												
12	31	32	33	34	35	36						

NOTE: Not more than 4 corners, all in the same town and range, may be recorded on this certificate.

A. Description of original monument and accessories and/or subsequent restoration:

- On August 6, 1848, William Ives set a post from which a 16" Y. birch bears N14°E, 11 links and a 6" hemlock - S46°W, 16 links.
- Northern States Power Company maps indicate corner position at centerline of road at the intersection of an east-west rock wall. Date unknown.

B. Description of corner evidence found and/or method applied in restoring or reestablishing corner:

No original evidence could be found due to road and utility construction, logging and farming. I reestablished the corner position at the centerline of road intersection with an east-west rock wall as shown on the N.S.P. map. This corner position is setting harmoniously with all area residents.

Record research form on file with Register of Deeds.

PEER GROUP APPROVED
Richard Dredman 4/6/95
COUNTY REPRESENTATIVE


C. Description of monument for corner and accessories established to perpetuate locating the position of the corner:

I set a hardened steel spike marked "Survey Marker" at the corner position, from which I established the following bearing trees and/or reference objects: Power pole - N71°E, 28.25 feet; light pole - S05°E, 170.18 feet. Two (2) reference monuments consisting of a 2 1/2" diameter x 30" long aluminum pipe with a 3 1/4" diameter aluminum cap stamped as follows:


- R.M. 1- County Remonumentation; T47N, R47W; R.M.; 1/4; S-26; S-25; 1995; RLS 28410; N58°E, 24.85 feet with a 6 foot steel rail with sign 0.91 feet away.
- R.M. 2- County Remonumentation; T47N, R47W; R.M.; 1/4; S-26; S-25; 1995; RLS 28410; S46°E, 27.26 feet with a 6 foot steel rail with sign 0.48 feet away.

SEE SKETCH ON BACK

Signed by John R. Garske Date 4-9-95
Surveyor's Michigan License No. 28410

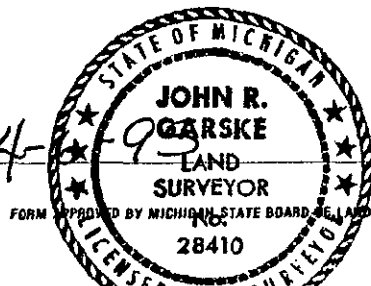

SKETCH:

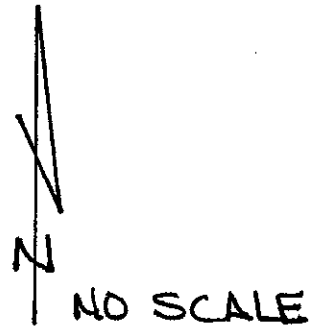

1/4 COR. 26 & 25
T47N, R47W

SET 4" LONG HARDENED STEEL
SPIKE marked "Survey Marker"

