

**SURVEY &  
REMONUMENTATION**

SEP 29 1994

**COMMISSION**

**LAND CORNER RECORDATION CERTIFICATE  
Filing Requirement of Act 74, Mich. P.A. 1970**

Register's Office }  
Gogebic County } ss.

Received for record the  
16 day of SEPT  
A. D. 1994 at 4:00 o'clock  
8 m., and recorded in  
Liber 5 of CORNERS

on page 123  
Ramona Collins, Deputo  
Register of Deeds

Register of Deeds Stamp & File Number

For corners in

Gogebic  
(County)

Located In:

Corner Code #

- |                                    |                           |            |
|------------------------------------|---------------------------|------------|
| 1. Public Land Survey              | T <u>47N</u> R <u>47W</u> | <u>L-7</u> |
|                                    | T _____ R _____           | _____      |
|                                    | T _____ R _____           | _____      |
|                                    | T _____ R _____           | _____      |
| 2. Property Controlling in Section | S _____ T _____ R _____   | _____      |
|                                    | S _____ T _____ R _____   | _____      |
| 3. Miscellaneous Property in Sec.  | S _____ T _____ R _____   | _____      |
|                                    | S _____ T _____ R _____   | _____      |

4. Lot No. \_\_\_\_\_, Recorded Plat \_\_\_\_\_

5. Private Claims \_\_\_\_\_

**One-quarter corner common to Sections 13 & 24.**

I, John R. Garske, in a field survey on June 21, 1994, do hereby certify that under requirements of P.A. 74, Michigan P.A. of 1970, the corner points mentioned in lines 1 and 2 above were in conformance with regulations and rules therefore as required in the current manual of survey instructions of the United States Department of the Interior, Bureau of Land Management or by a decree of a Court of Law and/or that the corner points mentioned in lines 3, 4 and 5 above were in conformance with the rules of the Michigan Board of Land Surveyors or by a Decree of a Court of Law; established, re-established, monumented, re-monumented, recovered, found as expressed below:

**NOTE: Not more than 4 corners, all in the same town and range, may be recorded on this certificate.**

	A	B	C	D	E	F	G	H	I	J	K	L	M
2	6	5	4	3	2	1							
3													
4	7	8	9	10	11	12							
5													
6	18	17	16	15	14	13							
7													
8	19	20	21	22	23	24							
9													
10	30	29	28	27	26	25							
11													
12	31	32	33	34	35	36							
13													

A. Description of original monument and accessories and/or subsequent restoration:

- On August 25, 1848, William Ives set a wood post from which an Elm 6" bears N45°E, 29 links and an Elm 7" bears S21°W, 15 links. No evidence of the original corner exists due to road construction.

- On May 21, 1986, J. Goss, RLS 23509 found a 1 1/4" drill steel rod using M.D.O.T. ties from plans of US-2 and recorded on Liber 2, P. 789. Accessories: Top of hydrant - S29°W, 52.60 feet; P. pole - S57°E, 61.12 feet; P. pole - N57°E, 43.18 feet; P. pole - N45°W, 34.04 feet.

B. Description of corner evidence found and/or method applied in restoring or reestablishing corner:

I found a large P.K. nail marking corner position and checked with witnesses from Goss recordation certificate. I updated the corner as noted below to bring it up to county and state specifications.

Act 74 research on file with County Register of Deeds Office.

**PEER GROUP**

**Approved**


Richard L. Drabn

9/14/94

C. Description of monument for corner and accessories established to perpetuate locating the position of the corner:

I replaced found P.K. nail with a 2 1/2" brass cap with a 2" stem in anchoring cement. Brass cap is stamped: 1/4; S-13; S-24; T47N, R47W; 1994; RLS 28410. I established the following reference objects: A reference monument consisting of a 2 1/2" x 30" aluminum pipe with a 3 1/4" aluminum cap stamped to indicate corner position as follows: S48°W, 45.32 feet with a steel sign post 1.78 feet away; P. pole #50 - S57°E, 61.12 feet; top of hydrant - S29°W, 52.60 feet; P. pole #13-3-93/07 - N45°W, 34.04 feet.

Signed by John R. Garske Date 8/31/94  
Surveyor's Michigan License No. 28410

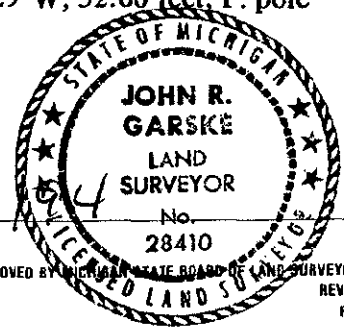

FORM APPROVED BY MICHIGAN STATE BOARD OF LAND SURVEYORS, JAN. 28, 1971  
REVISED MAY 14, 1975  
REVISED JAN., 1983