

**LAND CORNER RECORDATION CERTIFICATE**  
**Filing Requirement of Act 74, Mich. P.A. 1970**

For corners in

<u>Gogebic</u> (County)	Located In:	Corner Code #	
1. Public Land Survey	S-24 T <u>47N</u> R <u>47W</u>	<u>L-9</u>	
	T _____ R _____	_____	
	T _____ R _____	_____	
	T _____ R _____	_____	
2. Property Controlling in Section	S _____ T _____ R _____	_____	
	S _____ T _____ R _____	_____	
3. Miscellaneous Property in Sec.	S _____ T _____ R _____	_____	
	S _____ T _____ R _____	_____	

Register's Office }  
 Gogebic County } ss.

Received for record the  
21<sup>st</sup> day of JULY  
 A. D. 1995 at 1:50 o'clock  
P m., and recorded in  
 Liber 5 of CORNERS  
 on page 284  
Ramona Collins, Deputy  
 Register of Deeds

Register of Deeds Stamp & File Number

4. Lot No. \_\_\_\_\_, Recorded Plat \_\_\_\_\_  
 5. Private Claims \_\_\_\_\_

One-quarter corner common to Sections 24 and 25, T47N, R47W

I, John R. Garske, in a field survey on April 6, 1995, do hereby certify that under requirements of P.A. 74, Michigan P.A. of 1970, the corner points mentioned in lines 1 and 2 above were in conformance with regulations and rules therefore as required in the current manual of survey instructions of the United States Department of the Interior, Bureau of Land Management or by a decree of a Court of Law and/or that the corner points mentioned in lines 3, 4 and 5 above were in conformance with the rules of the Michigan Board of Land Surveyors or by a Decree of a Court of Law; established, re-established, monumented, re-monumented, recovered, found as expressed below:

A	B	C	D	E	F	G	H	I	J	K	L	M
2	6	5	4	3	2	1						
3												
4	7	8	9	10	11	12						
5												
6	16	17	16	15	14	13						
7												
8	19	20	21	22	23	24						
9												
10	30	29	28	27	26	25						
11												
12	31	32	33	34	35	36						
13												

**NOTE: Not more than 4 corners, all in the same town and range, may be recorded on this certificate.**

A. Description of original monument and accessories and/or subsequent restoration:

- On August 24, 1848, William Ives set a post from which a 7" cedar bears S38°E, 29 links and a 8" fir - N62°W, 29 links.
- The Assessor's Plat No. 14 to the City of Ironwood dated May 22, 1928. The corner position is shown but not called out as being a one-quarter corner.

B. Description of corner evidence found and/or method applied in restoring or reestablishing corner:


No evidence of the corner could be found due to logging and farming activity. I reestablished the corner position at the intersection of a north-south fence line and a fence line to the west, after comparing information on a single proportionate measurement and matching the position with Assessor's Plat No. 14.

Record research form on file with Register of Deeds.

**PEER GROUP APPROVED**  
Richard P. Dredge 7/10/95  
 COUNTY REPRESENTATIVE

C. Description of monument for corner and accessories established to perpetuate locating the position of the corner:

I set two 4 foot sections of 3/4" aluminum marsh rod with a 3 1/4" diameter aluminum cap stamped: County Remonumentation; T47N, R47W; S-24; S-25; 1/4; 1995; RLS 28410, from which I established the following bearing trees and/or reference objects:  
 5" cedar - N60°E, 48.88 feet  
 11" tamarack - S56°E, 124.17 feet  
 3" cedar - S60°W, 64.50 feet  
 6' steel rail with sign - North, 1.00 feet

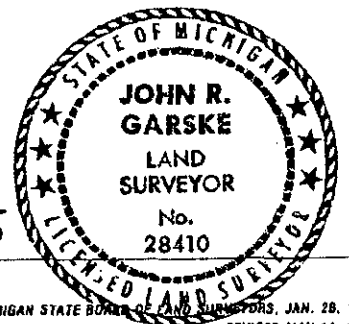

Signed by John R. Garske Date 5/4/95  
 Surveyor's Michigan License No. 28410