

SURVEY & REMONUMENTATION

JUN 29 1995

COMMISSION

LAND CORNER RECORDATION CERTIFICATE
Filing Requirement of Act 74, Mich. P.A. 1970

For corners in

	<u>Gogebic</u> (County)	Located In:	Corner Code -#
1. Public Land Survey	S-36	T <u>47N</u> R <u>47W</u>	<u>L-13</u>
		T _____ R _____	_____
		T _____ R _____	_____
		T _____ R _____	_____
2. Property Controlling in Section	S _____	T _____ R _____	_____
	S _____	T _____ R _____	_____
3. Miscellaneous Property in Sec.	S _____	T _____ R _____	_____
	S _____	T _____ R _____	_____

Register's Office }
Gogebic County } ss.

Received for record the
12TH day of APRIL
A. D. 1995 at 1:15 o'clock
P m., and recorded in
Liber 5 of CORNERS
on page 238
Ramona Collins Deputy
Register of Deeds

Register of Deeds Stamp & File Number

4. Lot No. _____, Recorded Plat _____
5. Private Claims _____
One-quarter corner common to Section 36, T47N, R47W and Section 1, T46N, R47W.

	A	B	C	D	E	F	G	H	I	J	K	L	M
2	6		5		4		3		2		1		
3													
4	7		8		9		10		11		12		
5													
6	18		17		16		15		14		13		
7													
8	19		20		21		22		23		24		
9													
10	30		29		28		27		26		25		
11													
12	31		32		33		34		35		36		
13													

I, John R. Garske, in a field survey on March 30, 19 95, do hereby certify that under requirements of P.A. 74, Michigan P.A. of 1970, the corner points mentioned in lines 1 and 2 above were in conformance with regulations and rules therefore as required in the current manual of survey instructions of the United States Department of the Interior, Bureau of Land Management or by a decree of a Court of Law and/or that the corner points mentioned in lines 3, 4 and 5 above were in conformance with the rules of the Michigan Board of Land Surveyors or by a Decree of a Court of Law; established, re-established, monumented, re-monumented, recovered, found as expressed below:

NOTE: Not more than 4 corners, all in the same town and range, may be recorded on this certificate.

A. Description of original monument and accessories and/or subsequent restoration:

On September 6, 1847, William Austin Burt set a sugar post from which a 10" Y. birch bears N06°W, 12 links and a 6" sugar - N11°E, 24 links.

B. Description of corner evidence found and/or method applied in restoring or reestablishing corner:

No original evidence could be found due to road and utility construction, logging and farming. I reestablished the corner position by single proportionate measurement. The corner is set on township line and midway between the section corner common to Sections 36, 31, 1 and 6, and the section corner common to Sections 35, 36, 1 and 2. The corner location is in harmony with occupation lines to the north and to the south.


Record research on file with Register of Deeds.

PEER GROUP APPROVED
Richard P. Dieder 4/6/95
COUNTY REPRESENTATIVE

C. Description of monument for corner and accessories established to perpetuate locating the position of the corner:

I set a 2 1/2" diameter x 30" long aluminum pipe with a 3 1/4" diameter cap at the corner position. The cap is stamped: County Remonumentation; 1/4 cor.; T47N, T46N, R47W; S-36; S-1; 1995; RLS 28410, from which I established the following bearing trees and/or reference objects:

- 10" R. pine - N42°E, 39.74 feet
- Power pole - S29°E, 65.26 feet
- Clump of 4 - 4" R. maple - S69°W, 18.66 feet
- 6 foot steel rail with sign - N47°W, 1.75 feet

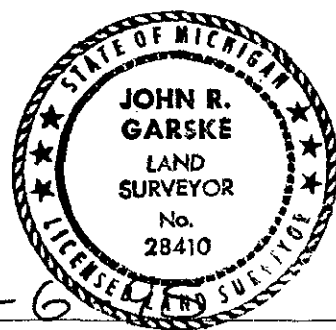

Signed by John R. Garske
Surveyor's Michigan License No. 28410

Date 4-6