

SURVEY & REMONUMENTATION

SEP 29 1994

COMMISSION

LAND CORNER RECORDATION CERTIFICATE
 Filing Requirement of Act 74, Mich. P.A. 1970

Register's Office } ss.
 Gogebic County }

For corners in
Gogebic
 (County)

Located In: Corner Code =#

- 1. Public Land Survey T 47N R 47W M-2
- T _____ R _____
- T _____ R _____
- T _____ R _____
- 2. Property Controlling S _____ T _____ R _____
- in Section S _____ T _____ R _____
- 3. Miscellaneous S _____ T _____ R _____
- Property in Sec. S _____ T _____ R _____

Received for record the
16th day of SEPTEMBER
 A. D. 1994 at 3:50 o'clock
P m., and recorded in
 Liber 5 of CORNERS
 on page 107
Ramona Collins, Deputy
 Register of Deeds

Register of Deeds Stamp & File Number

- 4. Lot No. _____, Recorded Plat _____
- 5. Private Claims _____

**One-quarter corner common to Section 1, T47N, R47W.
 and Section 6, T47N, R46W.**

I, John R. Garske in a field survey on June 3, 1994, do hereby certify that under requirements of P.A. 74, Michigan P.A. of 1970, the corner points mentioned in lines 1 and 2 above were in conformance with regulations and rules therefore as required in the current manual of survey instructions of the United States Department of the Interior, Bureau of Land Management or by a decree of a Court of Law and/or that the corner points mentioned in lines 3, 4 and 5 above were in conformance with the rules of the Michigan Board of Land Surveyors or by a Decree of a Court of Law; established, re-established, monumented, re-monumented, recovered, found as expressed below:

	A	B	C	D	E	F	G	H	I	J	K	L	M
2	6	5	4	3	2	1							
3													
4	7	8	9	10	11	12							
5													
6	10	17	16	15	14	13							
7													
8	19	20	21	22	23	24							
9													
10	30	29	28	27	26	25							
11													
12	31	32	33	34	35	36							
13													

NOTE: Not more than 4 corners, all in the same town and range, may be recorded on this certificate.

A. Description of original monument and accessories and/or subsequent restoration:


- Original corner set September 9, 1851, by John Burt, D.S., for William A. Burt, D.S., corner was set on north line, T47N, R46W intersecting range line 1.75 chains south of post and set cedar post corner of T47 and 48N between R46 and 47W. Original bearing trees: 18" hemlock - S38°W, 32 links; 14" Y. birch - S37°E, 33 links.
- Survey on March 4, 1991, by John R. Garske, RLS 28410, set 1/4 corner by single proportional measurement on the range line in accordance with the original government field notes. No original evidence of the corner position now remains. The corner fall 8 feet ± west of the centerline of the existing gravel county road (Look Out Lane) opposite a rock wall fence to the west and a tree line to the east. Set P.K. nail in frozen road bed. Bearing trees: 6" ash - S74°W, 21.25 feet; 12" S. maple (triple) - S63°E, 53.79 feet; 16" Y. birch - S15°W, 70.17 feet.

B. Description of corner evidence found and/or method applied in restoring or reestablishing corner:

Found bearing trees as described above and in recordation certificate of Liber 3, P. 418. I re-established the corner position from these witnesses and monumented the corner along with upgrading the accessories to county and state specifications as described below.

Act 74 research on file with County Register of Deeds Office.

PEER GROUP **Approved**
Richard L. Dralun 9/14/94

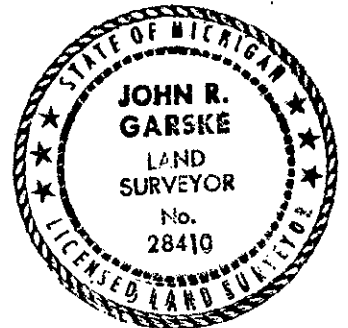

C. Description of monument for corner and accessories established to perpetuate locating the position of the corner:

I set a 3/4" x 24" rebar with a 3 1/4" aluminum cap stamped: County Remonumentation; 1/4; T47N, R47-46W; S-1; S-6; 1994; RLS 28410. Corner is 4" below gravel road surface. Established the following bearing trees and reference objects:

- 10" maple (triple) - S63°E, 53.79 feet
- 16" Y. birch - S15°W, 70.17 feet
- 6" maple - S74°W, 21.25 feet

Reference monument - 2 1/2" x 30" aluminum pipe with a 3 1/4" aluminum cap stamped to indicate corner position - N27°E, 62.14 feet with a steel sign post 1.50 feet away.

Signed by John R. Garske Date 8/30/94
 Surveyor's Michigan License No. 28410