

**SURVEY &  
REMONUMENTATION**

SEP 29 1994

**COMMISSION**

**LAND CORNER RECORDATION CERTIFICATE  
Filing Requirement of Act 74, Mich. P.A. 1970**

Register's Office }  
Gogebic County } ss.

Received for record the  
16 day of SEPT  
A. D. 1994 at 4:10 o'clock  
P m., and recorded in  
Liber 5 of CORNER

on page 141  
Ramona Collins, Deputy  
Register of Deeds

Register of Deeds Stamp & File Number

For corners in

Gogebic

(County)

Located In:

Corner Code #

- |                                       |                           |             |
|---------------------------------------|---------------------------|-------------|
| 1. Public Land Survey                 | T <u>47N</u> R <u>47W</u> | <u>M-13</u> |
|                                       | T _____ R _____           | _____       |
|                                       | T _____ R _____           | _____       |
|                                       | T _____ R _____           | _____       |
| 2. Property Controlling<br>in Section | S _____ T _____ R _____   | _____       |
|                                       | S _____ T _____ R _____   | _____       |
| 3. Miscellaneous<br>Property in Sec.  | S _____ T _____ R _____   | _____       |
|                                       | S _____ T _____ R _____   | _____       |

4. Lot No. \_\_\_\_\_, Recorded Plat \_\_\_\_\_

5. Private Claims \_\_\_\_\_

**Township corner common to Sections 36, 31, 1 & 6, T47-46N,  
R47-46W**

June 20 94

I, John R. Garske, in a field survey on \_\_\_\_\_, 19 \_\_\_\_\_, do hereby certify that under requirements of P.A. 74, Michigan P.A. of 1970, the corner points mentioned in lines 1 and 2 above were in conformance with regulations and rules therefore as required in the current manual of survey instructions of the United States Department of the Interior, Bureau of Land Management or by a decree of a Court of Law and/or that the corner points mentioned in lines 3, 4 and 5 above were in conformance with the rules of the Michigan Board of Land Surveyors or by a Decree of a Court of Law; established, re-established, monumented, re-monumented, recovered, found as expressed below:

**NOTE: Not more than 4 corners, all in the same town and range, may be recorded on this certificate.**

A. Description of original monument and accessories and/or subsequent restoration:

On September 3, 1847, William A. Burt set a hemlock post at town corner from which a Y. Birch 16" bears S25°E, 25 links and a hemlock 18" bears S52°W, 21 links.

No original evidence found due to road construction.

**PEER GROUP**

**Approved**

Richard L. Dralun

9/14/94

B. Description of corner evidence found and/or method applied in restoring or reestablishing corner:

Found a 2' long x 2" diameter pointed iron pipe 4" below road surface. Pipe was found to be bent and in poor condition. I carefully dug up corner and replaced it at the mark the point of the pipe left in our excavation. I accepted the corner as being true due to the substantial pipe found, at the proper location within the intersection of South Davis and East Pioneer Road. This pipe has been used and accepted as the section corner for many years.

After restoring the corner position, I upgraded it as noted below to state and county specifications. Corner was found 0.50 feet west of the approximate centerline of South Davis Road and 1.50 feet north of the approximate centerline of East Pioneer Road.


Research record form on file with County Register of Deeds Office.

C. Description of monument for corner and accessories established to perpetuate locating the position of the corner:

I replaced found bent iron pipe with a 1" x 36" iron pipe with a 2 1/2" brass cap with a 2" stem on top of pipe set in anchoring cement 3" below road surface. I established the following bearing trees and reference objects: A reference monument consisting of a 2 1/2" x 30" aluminum pipe with a 3 1/4" aluminum cap stamped to indicate the corner position as follows: S47°E, 48.12 feet with a steel sign post 1.71 feet away; 14" R. pine - N20°E, 108.44 feet; P. pole #5 - S45°E, 39.82 feet; P. pole #1 - 94/93 - S52°W, 41.87 feet.

Signed by John R. Garske  
Surveyor's Michigan License No. 28410

Date 8/31/94

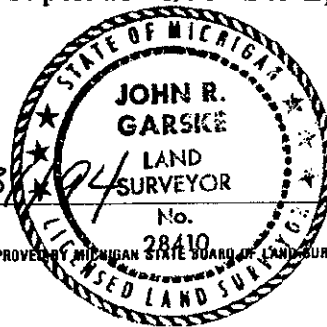

FORM APPROVED BY MICHIGAN STATE BOARD OF LAND SURVEYORS, JAN. 26, 1971  
REVISED MAY 14, 1975  
REVISED JAN., 1983