For corners in Gogebic County) LAND CORNER RECORDATION CERTIFICATI Filing Requirement of Act 74, Mich. P.A. 1976 Corner Code ##					
1.	Public Land Survey	T <u>47N R 47W</u> T R T R T R	C-1-2 Ooa	Liber 5 of CORNESS on page 173 Ramona Collins, Deputy	
	Property Controlling in Section Miscellaneous Property in Sec.	S T R S T R S T R S T R	F	Register of Beeds Register of Deeds Stamp & File Number	
5. I, _ do in I cur Ma abo	Private Claims Meander corner co John R. Garske hereby certify that under requires 1 and 2 above were inconagement or by a decree of a cope were in conformance with	in a field survey on	December 7 , 19 94 , of 1970, the corner points mentioned d rules therefore as required in the ment of the Interior, Bureau of Land r points mentioned in lines 3, 4 and 5 f Land Surveyors or by a Decree of a	A B C D E F G H I J K L M 2 6 5 4 3 2 - 1 3 4 7 8 9 10 11 - 12 5 6 18 17 16 15 14 13 7 6 19 20 21 22 23 24 9	
Court of Law; established, re-established, monumented, re-monumented, recovered, found as expressed below: NOTE: Not more than 4 corners, all in the same town and range, may be recorded on this certificate.				11 1 1 1 1 1 1 1 1 1 1 1 1 1 1 1 1 1 1 1	
A.	Original surve and original be 14 links (9.24	earing trees are: Hemlock	/ Surveyor, in 1848. Original of 12" - N30°E, 22 links (14.52°)	omer was a wooden post); Hemlock 26" - N58°W,	

B. Description of corner evidence found and/or method applied in restoring or reestablishing corner:

No original evidence could be found. Corner position was re-established by using information from D.S.S. & A. (now C & NW) railroad maps dated 1916. Section line crosses the centerline of the railroad 145.4 feet easterly from the center of bridge over the Montreal River. I then extended the section line from the section corner to the north through this point to the edge of the river and set the corner in a logical location to protect and preserve its position. No other information could be found to assist in locating the corner.


Record research form on file with County Register of Deeds office. See sketch on back.

C. Description of monument for corner and accessories established to perpetua

Set a 1-4 foot section of 3/4" diameter aluminum marsh rod with a 3 1/4" aluminum cap stamped: County Remonumentation; T47N, R47W, S-6; S-5; M.C.; 1994; RLS 28410. Corner location is at the bottom of a 6' bank. I established the following bearing trees and reference objects: 8" R. maple - N85°E, 16.92 feet; 12" R. maple - S29°W, 15.42 feet; 6" R. maple - N80°W, 16.04 feet; clump of 3-4" R. maple - N28°W, 12.20 feet; 6' steel rail with sign - N45°E, 1.88 feet.

Signed by Surveyor's Michigan License No.

JOHN R. Garske LAND JRYEYO

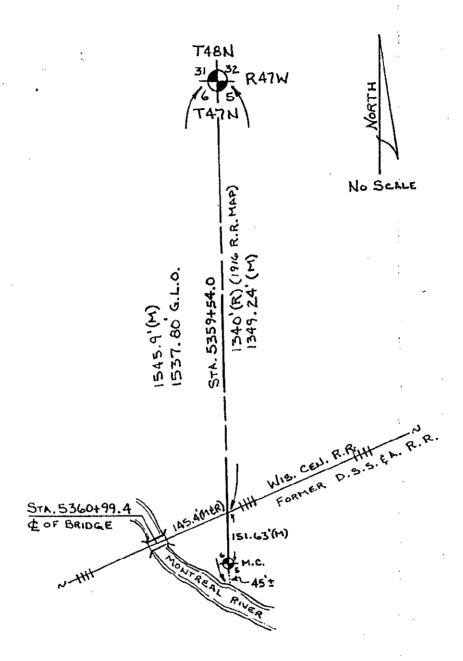

ş