

SURVEY & REMONUMENTATION

JAN 22 1998

LAND CORNER RECORDATION CERTIFICATE
Filing Requirement of Act 74, Mich. P.A. 1970

Register's Office } ss.
Gogebic County }

SECTION
For corners in
Gogebic

Located In: Corner Code #

- 1. Public Land Survey
- 2. Property Controlling in Section
- 3. Miscellaneous Property in Sec.

Section 14 47N 47W 1-6
 T R
 T R
 T R
 T R
 S T R
 S T R
 S T R
 S T R

Seg 12

Received for record the
22ND day of DECEMBER
A. D. 1997 at 11:00 o'clock
A m., and recorded in
Liber 6 of CORNER
on page 301
Ramona Collins, Deputy
Register of Deeds

Register of Deeds Stamp & File Number

- 4. Lot No. _____, Recorded Plat _____
- 5. Private Claims
1/4 corner section 14 & 15

John R. Garske

December 11, 1997

I, _____, in a field survey on _____, 19____ do hereby state that under requirements of P.A. 74, Michigan P.A. of 1970, the corner points mentioned in lines 1 and 2 above were in conformance with regulations and rules therefore as required in the current manual of survey instructions of the United States Department of the Interior, Bureau of Land Management or by a decree of a Court of Law and for that the corner points mentioned in lines 3, 4 and 5 above were in conformance with the rules of the Michigan Board of Land Surveyors or by a Decree of a Court of Law; established, re-established, monumented, recovered, found as expressed below:

1	A	B	C	D	E	F	G	H	I	J	K	L	M
2		6		5		4		3		2		1	
3													
4		7		8		9		10		11		12	
5													
6		18		17		16		15		14		13	
7													
8		19		20		21		22		23		24	
9													
10		30		29		28		27		26		25	
11													
12		31		32		33		34		35		36	
13													

NOTE: Not more than 2 corners, all in the same town and range, may be recorded on this certificate.

A. Description of original monument and accessories and/or subsequent restoration:

- A.
 - 1- 1848 - Corner established by William Ives D.S., set wood post form which: Fir - 4" - N68°E - 68 links, Fir 10" - 57°W - 40 links.
 - 2 - 1977 - corner found by Ewart Muller, RLS 15408, Rec Ls, pg. 325
 - 3 - 1981 - corner reset by John Goss, RLS 23509, Rec. 2, p 103
 - 4 - 1994 corner updated by John Garske, RLS 28410, rec L5, pg. 118.


PEER GROUP APPROVED
Richard L. Dean 12/19/97
COGEBIC SUPERVISOR

B. Description of corner evidence found and/or method applied in restoring or reestablishing corner:

- 2 - All accessories destroyed during road construction.
- 3 - John Goss reset the corner after road construction with new accessories: set 1" x 24" iron rod
 Spruce 12" S30°W 62.65 feet (destroyed)
 Power Pole N48°W 40.69 feet (existing - good condition)
 Sign Post N33°E 90.85 feet (existing)
 Sign Post N52°E 41.34 feet (existing good - condition)
- 4 - Corner position and reference monument destroyed. I reset the corner from previous survey information in the area and existing ties noted above and below.

(Research on file)

C. Description of monument for corner and accessories established to perpetuate locating the position of corner:

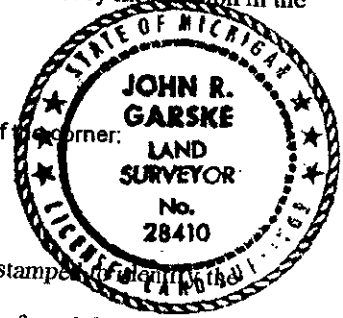

Reset corner with a 5/8" x 10" iron rod with a 3/4" dia. brass cap 3" below the pavement stamped with the name of the corner:
 Reset reference monument - N56°E - 38.97 feet (R&M), Power Pole - 1.66' to face of Pole from Monument.
 R.M. - reset a 3/4" x 30" iron rod with a 3 1/4" dia. alum. cap
 (R.M. - S22°E - 74.29 feet (destroyed not reset) (Garske)

- Power Pole N56°E M 41.34 feet (M&R) (existing) (Goss)
- Power Pole S35°W 47.69 feet (M&R) (existing) (Goss)
- Power Pole N48°W 40.69 feet (M&R) (existing) (Goss)

Signed by John R. Garske
Surveyor's Michigan License No. 28410

Date 12/19/97