

SURVEY & REMONUMENTATION

JAN 05 2001

SECTION

LAND CORNER RECORDATION CERTIFICATE
Filing Requirement of Act 74, Mich. P.A. 1970

Register's Office }
Egobic County } ss.

For corners in

GOGBIC
(County)

Located In: Corner Code #

- 1. Public Land Survey T48N 44W B-7
- T ___ R ___
- T ___ R ___
- T ___ R ___
- 2. Property Controlling S ___ T ___ R ___
- in Section S ___ T ___ R ___
- 3. Miscellaneous S ___ T ___ R ___
- Property in Sec. S ___ T ___ R ___

Quarter corner, Sections 18 & 19, T48N, R44W

- 4. Lot No. _____, Recorded Plat _____
- 5. Private Claims _____

Received for record the
2ND day of OCTOBER
A. D. 19⁰⁰ at 10:50 o'clock
A m., and recorded in
Liber 8 of CORNERS
on page 24
Naimona Collins Deputy
Register of Deeds

Register of Deeds Stamp & File Number

I, John P. Goss, in a field survey on Sept. 18, 2000 do hereby state that under requirements of P.A. 74, Michigan P.A. of 1970, the corner points mentioned in lines 1 and 2 above were in conformance with regulations and rules therefore as required in the current manual of survey instructions of the United States Department of the Interior, Bureau of Land Management or by a decree of a Court of Law and /or that the corner points mentioned in lines 3, 4 and 5 above were in conformance with the rules of the Michigan Board of Land Surveyors or by a Decree of a Court of Law; established, re-established, monumented, recovered, found as expressed below;

NOTE: Not more than 2 corners, all in the same town and range, may be recorded on this certificate.

A	B	C	D	E	F	G	H	I	J	K	L	M
1												
2	6	5	4	3	2	1						
3												
4	7	8	9	10	11	12						
5												
6	18	17	16	15	14	13						
7	●											
8	19	20	21	22	23	24						
9												
10	30	29	28	27	26	25						
11												
12	31	32	33	34	35	36						
13												

A. Description of original monument and accessories and/or subsequent restoration:

Corner established by Austin Burt, in 1848.

Original bearing trees: Hemlock 12 S 26° E 8 links (5.28 ft.)
Yellow Birch 16" N 30½° W 31 links (20.46 ft.)

Donald D. Lappala, 12585, restored corner position at record bearing and distances from the two original bearing trees on Sept. 11, 1972. The first one was decayed hemlock stump. The second one a 30" live yellow birch. He set a 2" I.D. iron pipe with 3" bronze tablet, stamped to indicated the corner position. He established the following reference objects:

8" Red Maple N 02° E 37.3 ft.; 7" Hemlock S 85° E 27.9 ft.;

B. Description of corner evidence found and/or method applied in restoring or reestablishing corner:

6" Hemlock S 47° W 34.8 ft.; A metal sign post N 14° E 2.6 ft.
He recorded said corner in U.S.F.S. Liber, Index N-3 on Dec. 9, 1974.

Found the two original bearing trees. The first is a decayed hemlock stump at ground level. The second one is now a 38" live yellow birch with G.L.O. blaze visible.

Found Donald D. Lappala monument and accessories.


Act 74 research on file.

DEED GROUP APPROVED
Richard L. Decker 9/27/00
COURT RECORDED

C. Description of monument for corner and accessories established to perpetuate locating the position of the corner:

From found monument stamped to read: T.48 N., R.44 W.; 1/4; S-18, S-19; R.L.S. 12585; 1972, from which I established the following existing and new reference objects:

- 10" Red Maple N 02° E 37.24 ft.
 - 8" Hemlock S 85° E 27.95 ft.
 - 9" Hemlock S 47° W 34.77 ft.
 - 14" Hemlock N 78° W 8.43 ft.
 - A metal sign post N 14° E 2.55 ft. to face
- (All measurement taken to nail in side of tree)

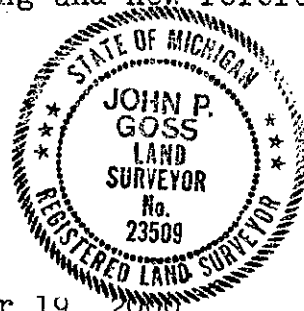

Signed by John P. Goss
Surveyor's Michigan License No. 23509

Date September 19, 2000

U.S.F.S. No. N-3