

LAND CORNER RECORDATION CERTIFICATE
 Filing Requirement of Act 74, Mich. P.A. 1970

Register's Office }
 Saginaw County } ss.

Received for record the
26th day of MAY
 A. D. 2000 at 11:10 o'clock
A m., and recorded in
 Liber 7 of CORNER
 ** page 333
Cheryl Ruppe
 Dep. Register of Deeds

For corners in

GOGEBIC

(County)

Located In:

Corner Code #

1. Public Land Survey

T48N R 44W

B-11

T ___ R ___

T ___ R ___

T ___ R ___

S ___ T ___

S ___ T ___

S ___ T ___

S ___ T ___

SURVEY &

MONUMENTATION

JAN 05 2001

SECTION

Register of Deeds Stamp & File Number

4. Lot No. _____, Recorded Plat _____

5. Private Claims _____

Quarter Corner, Sections 30 & 31, T48N, R44W

I, John P. Goss, in a field survey on May 23, 2000 do hereby state that under requirements of P.A. 74, Michigan P.A. of 1970, the corner points mentioned in lines 1 and 2 above were in conformance with regulations and rules therefore as required in the current manual of survey instructions of the United States Department of the Interior, Bureau of Land Management or by a decree of a Court of Law and /or that the corner points mentioned in lines 3, 4 and 5 above were in conformance with the rules of the Michigan Board of Land Surveyors or by a Decree of a Court of Law; established, re-established, monumented, recovered, found as expressed below:

NOTE: Not more than 2 corners, all in the same town and range, may be recorded on this certificate.

	A	B	C	D	E	F	G	H	I	J	K	L	M
1													
2	6	5	4	3	2	1							
3													
4	7	8	9	10	11	12							
5													
6	18	17	16	15	14	13							
7													
8	19	20	21	22	23	24							
9													
10	30	29	28	27	26	25							
11	●												
12	31	32	33	34	35	36							
13													

A. Description of original monument and accessories and/or subsequent restoration:
 Corner established by Austin Burt, in 1848.

Original bearing trees: Tamarack 4" S 25° E 44 links (29.04 ft.)
 Tamarack 6" N 27½° W 10 links (6.60 ft.)

Donald D. Lappala, 12585, on August 31, 1972, restored corner position at record bearing and distance from the stump hole of 1st B.T. and decayed stump of the second B.T. and record natural features. He set a 2" I.D. iron pipe with a 3" bronze tablet, stamped to indicated the corner position. He established the following reference objects: 8" Y. Birch - N 28° E - 32.5 ft.; 5" Cedar - N 67° E - 4.4 ft.; 6" Y. Birch (Stub) - S 80° W - 27.2 ft.; metal sign post - N 18° E - 2.2 ft.

B. Description of corner evidence found and/or method applied in restoring or reestablishing corner:

He recorded said corner in U.S.F.S. Liber, Index No. V-3 on Dec. 9, 1974.

No original evidence found.

Found Donald D. Lappala monument and accessories.


Act 74 research on file.

PEER GROUP APPROVED
Richard P. Deahn 05/26/00
 COUNTY REGISTER

C. Description of monument for corner and accessories established to perpetuate locating the position of the corner:

From the found monument stamped to read: T.48 N., R.44 W.; 1/4; S-30, S-31; R.L.S. 12585; 1972, from which I established the following existing and new reference objects:

9" Yellow Birch	N 28° E	32.49 ft. nail
8" Cedar	N 67° E	4.43 ft. nail
7" Yellow Birch (stub)	S 80° W	27.2 ft. no nail
6" Maple	N 36° W	14.28 ft. nail
Metal sign post	N 18° E	2.60 ft. to face

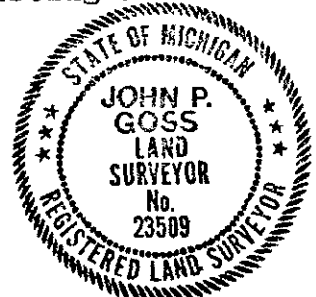

Signed by John P. Goss

Surveyor's Michigan License No. 23509

U.S.F.S. No. V-3

Date May 23, 2000