

LAND CORNER RECORDATION CERTIFICATE
Filing Requirement of Act 74, Mich. P.A. 1970

Register's Office }
Gogebic County } ss.

Received for record the
25TH day of AUGUST
A. D. 1900 at 1:20 o'clock
P m., and recorded in
Liber 8 of CORNERS
on page 13
Bermon Collins, Deputy
Register of Deeds

For corners in

GOGEBIC

(County)

Located In:

Corner Code #

1. Public Land Survey

T48N R44W C-8

T___ R___
T___ R___ **SURVEY &**
T___ R___ **MONUMENTATION**

2. Property Controlling
in Section

S___ T___ R___

3. Miscellaneous

S___ T___ R___

Property in Sec.

S___ T___ R___

JAN 05 2001

SECTION

Register of Deeds Stamp & File Number

4. Lot No. _____, Recorded Plat _____

5. Private Claims _____

Quarter corner, Sections 19 & 20, T48N, R44W

I, John P. Goss, in a field survey on Aug. 21, 2000 do hereby state that under requirements of P.A. 74, Michigan P.A. of 1970, the corner points mentioned in lines 1 and 2 above were in conformance with regulations and rules therefore as required in the current manual of survey instructions of the United States Department of the Interior, Bureau of Land Management or by a decree of a Court of Law and /or that the corner points mentioned in lines 3, 4 and 5 above were in conformance with the rules of the Michigan Board of Land Surveyors or by a Decree of a Court of Law; established, re-established, monumented, recovered, found as expressed below:

NOTE: Not more than 2 corners, all in the same town and range, may be recorded on this certificate.

	A	B	C	D	E	F	G	H	I	J	K	L	M
1													
2	6		5		4		3		2		1		
3													
4	7		8		9		10		11		12		
5													
6	18		17		16		15		14		13		
7													
8	19		20		21		22		23		24		
9													
10	30		29		28		27		26		25		
11													
12	31		32		33		34		35		36		
13													

A. Description of original monument and accessories and/or subsequent restoration:

Corner established by Austin Burt, in 1848.

Original bearing trees: Tamarack 12" S 84° E 43 links (28.38 ft.)
Tamarack 12" N 73° W 38 links (25.08 ft.)

Donald D. Lappala, 12585, on Aug. 21, 1972, restored corner position at record bearing and distance from the remains of the two original bearing trees. He set a 2" I.D. iron pipe with 3" bronze tablet, stamped to indicated the corner position. He established the following reference objects:

X Chiesled on top of rock N 73° W 25.6 ft.; 9" Tamarack S 12° E 117.5 ft.
X chiesled on top of rock N 80° E 8.5 ft.; Metal sign post N 55° E 2.4 ft.

B. Description of corner evidence found and/or method applied in restoring or reestablishing corner:

He recorded said corner in U.S.F.S. Liber, Index P-5, on Dec. 9, 1974.

Found Donald D. Lappala monument and accessories.


Act 74 research on file.

DEED GROUP APPROVED
Richard P. Dean 8/23/00
COUNTY SUPERVISOR

C. Description of monument for corner and accessories established to perpetuate locating the position of the corner:

From found monument stamped T.48 N., R.44 W.; 1/4; S-19, S-20; R.L.S. 12585; 19' from which I established the following existing and new reference objects:

X Chiesled on top of boulder 1' by 2 1/2' N 73° W 25.6 ft.
X chiesled on top of boulder 1' by 1 1/2' N 80° E 8.5 ft.
14" Tamarack S 12° E 117.45 ft. to nail
Metal sign post N 55° E 2.30 ft. to face
6' Rail & sign S 82° W 6.28 ft. to face
6' Rail & sign N 02° E 4.93 ft. to face.

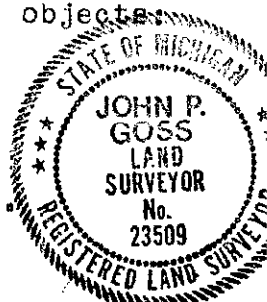

Signed by John P. Goss

Date Aug. 21, 2000

Surveyor's Michigan License No. 23509

U.S.F.S. No. P-5