

**LAND CORNER RECORDATION CERTIFICATE**  
Filing Requirement of Act 74, Mich. P.A. 1970

Register's Office }  
Gogebic County } ss.

Received for record the  
26<sup>TH</sup> day of MAY  
A. D. 1900 at 11:10 o'clock  
A m., and recorded in  
Liber 7 of CORNERS  
at page 336  
*Cheryl Rippe*  
Dep. Register of Deeds

For corners in

GOGEBIC

(County)

Located In:

Corner Code #

1. Public Land Survey

T48N R44W

D-9

T\_\_\_ R\_\_\_

T\_\_\_ R\_\_\_

T\_\_\_ R\_\_\_

S\_\_\_ T\_\_\_ R\_\_\_

S\_\_\_ T\_\_\_ R\_\_\_

S\_\_\_ T\_\_\_ R\_\_\_

S\_\_\_ T\_\_\_ R\_\_\_

**SURVEY &  
MONUMENTATION**

**JAN 05 2001**

**SECTION**

2. Property Controlling  
in Section

3. Miscellaneous  
Property in Sec.

4. Lot No. \_\_\_\_\_, Recorded Plat \_\_\_\_\_

5. Private Claims \_\_\_\_\_

Quarter Corner, Sections 20 & 29, T48N, R44W

I, John P. Goss, in a field survey on April 5<sup>th</sup> 2000 do hereby state that under requirements of P.A. 74, Michigan P.A. of 1970, the corner points mentioned in lines 1 and 2 above were in conformance with regulations and rules therefore as required in the current manual of survey instructions of the United States Department of the Interior, Bureau of Land Management or by a decree of a Court of Law and /or that the corner points mentioned in lines 3, 4 and 5 above were in conformance with the rules of the Michigan Board of Land Surveyors or by a Decree of a Court of Law; established, re-established, monumented, recovered, found as expressed below:

NOTE: Not more than 2 corners, all in the same town and range, may be recorded on this certificate.

	A	B	C	D	E	F	G	H	I	J	K	L	M
1													
2	6		5		4		3		2		1		
3													
4	7		8		9		10		11		12		
5													
6	18		17		16		15		14		13		
7													
8	19		20		21		22		23		24		
9													
10	30		29		28		27		26		25		
11													
12	31		32		33		34		35		36		
13													

A. Description of original monument and accessories and/or subsequent restoration:

Corner established by Austin Burt, in 1848.

Original bearing trees: Hemlock 20" S 19° E 34 links (22.44 ft.)  
Hemlock 20" N 40° W 25 links (16.50 ft.)

Donald D. Lappala, 12585, on August 31, 1972, restored corner position at recorded bearing and distance from the two original bearing trees. He set a 2" I.D. iron pipe with 3" bronze tablet, stamped to indicate the corner position. He established the following reference objects: 7" S. Maple - N 79° W - 32.2 ft.; 10" R. Maple - N 40° E - 31.7 ft.; 6" S. Maple - S 23° E - 42.8 ft.; A metal sign post - N 14° E - 2.8 ft.

B. Description of corner evidence found and/or method applied in restoring or reestablishing corner:

On December 9, 1974, he recorded said corner in U.S.F.S. Liber, Index No. R-7.

The first original bearing tree is now a badly decayed hemlock stump at ground level.

Found Donald D. Lappala monument and accessories.


Act 74 research on file.

NEED GROUP APPROVAL  
*Richard E. Dean 05/24/00*  
COUNTY REGISTER

C. Description of monument for corner and accessories established to perpetuate locating the position of the corner:

From the found monument stamped to read: T.48 N., R.44 W.; 1/4; S-20, S-29; R.L.S. 12585; 1972, from which I established the following existing and new reference objects:

9" Sugar Maple N 79° W 32.14 ft.  
15" Red Maple N 40° E 31.79 ft.  
9" Sugar Maple S 23° E 42.93 ft.  
9" Tw. Sugar Maple S 40° W 17.80 ft.  
A metal sign post N 14° E 2.76 ft. to face  
(All measurement taken to nail in side of tree)

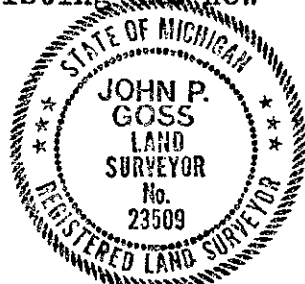

Signed by John P Goss

Date April 5, 2000

Surveyor's Michigan License No. 23509

U.S.F.S. No: R-7