

LAND CORNER RECORDATION CERTIFICATE
Filing Requirement of Act 74, Mich. P.A. 1970

Register's Office }
Gogebic County } ss.

For corners in
GOGEBIC
(County)

Located In: Corner Code #

1. Public Land Survey T48N R 44W E-11
T___ R___
T___ R___
T___ R___ **SURVEY &**
2. Property Controlling S___ T___ R___ **REMONUMENTATION**
in Section S___ T___ R___
3. Miscellaneous S___ T___ R___ **JAN 05 2001**
Property in Sec. S___ T___ R___
SECTION

4. Lot No. _____, Recorded Plat _____
5. Private Claims _____

Section corner, Sections 28, 29, 32, & 33, T48N, R44W

I, John P. Goss, in a field survey on April 7, 2000 do hereby state that under requirements of P.A. 74, Michigan P.A. of 1970, the corner points mentioned in lines 1 and 2 above were in conformance with regulations and rules therefore as required in the current manual of survey instructions of the United States Department of the Interior, Bureau of Land Management or by a decree of a Court of Law and/or that the corner points mentioned in lines 3, 4 and 5 above were in conformance with the rules of the Michigan Board of Land Surveyors or by a Decree of a Court of Law; established, re-established, monumented, recovered, found as expressed below:

NOTE: Not more than 2 corners, all in the same town and range, may be recorded on this certificate.

	A	B	C	D	E	F	G	H	I	J	K	L
1												
2	6		5		4		3		2		1	
3												
4	7		8		9		10		11		12	
5												
6	18		17		16		15		14		13	
7												
8	19		20		21		22		23		24	
9												
10	30		29		28		27		26		25	
11												
12	31		32		33		34		35		36	
13												

A. Description of original monument and accessories and/or subsequent restoration:

Corner established by Austin Burt, in 1848.

Original bearing trees: Sugar Maple 16" S 56° E 18 links (11.88 ft.)
Yellow Birch 30" N 40° W 25 links (16.50 ft.)

Donald D. Lappala, 12585, on August 7, 1972, re-established corner position by reference markers and original field ties. He set a 5/8" by 12" long iron pin in tangent line of centerline of Old M-28. He established the following referer objects: At 25.40 feet west of the corner he set a 2 1/2" I.D. iron pipe with 3" ca stamped to indicated the corner position; 9" Elm- N62°E- 27.0 ft. dead; 10" Elm S58°W - 83.6 ft. dead; Power Pole #158 - N28°W- 43.4 ft. cut down; a metal sign

B. Description of corner evidence found and/or method applied in restoring or reestablishing corner: post - N86°W- 24.0 ft. In 1986 the following were added: 9" S. Maple - S45°E - 63.16 ft.; 9" S. Maple S69°W - 77.45 ft. down; Power Pole #150 - S51°W- 41.00 ft.

On Dec. 9, 1974, Lappala recorded said corner in U.S.F.S. Liber, Index No. V-9.

Found Lappala monument and accessories and the added accessories.

Act 74 research on file.


WITH GROUP APPROVED
Richard P. Deahn 05/24/00
COUNTY REGISTER

C. Description of monument for corner and accessories established to perpetuate locating the position of the corner:

2" below surface I placed a 3 1/2" aluminum cap over the 5/8" iron pin, cap stamped to read: County Remonumentation; T.48 N., R.44 W., S-28, S-29, S-32, S-33; P.S. 23509; 2000. From which I established the following existing and new reference object:

Reference Monument	West	25.40 ft.
9" Sugar Maple	S 45° E	63.16 ft.
Power Pole # 150	S 51° W	41.00 ft.
Metal sign post	N 86° W	24.0 ft. to face

(all measurement taken to nail in side of object)

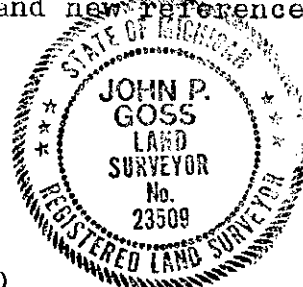

Signed by John P. Goss
Surveyor's Michigan License No. 23509

Date April 7, 2000

U.S.F.S. No. V-9