

LAND CORNER RECORDATION CERTIFICATE Register's Office }  
Gogebic County } ss.  
Filing Requirement of Act 74, Mich. P.A. 1970

For corners in

GOGEBIC  
(County)

Located in:

Corner Code #

1. Public Land Survey

T48NR 44W E-12  
T R SURVEY &  
T R MONUMENTATION

2. Property Controlling in Section

S T R  
S T R JAN 05 2001

3. Miscellaneous Property in Sec.

S T R  
S T R SECTION

Received for record the  
26<sup>TH</sup> day of MAY  
A. D. 2000 at 11:20 o'clock  
A m., and recorded in  
Liber 7 of CORNELIUS  
on page 342  
Chester Ruppel  
Dep. Register of Deeds  
Register of Deeds Stamp & File Number

4. Lot No. \_\_\_\_\_, Recorded Plat \_\_\_\_\_  
5. Private Claims \_\_\_\_\_

I, John P. Goss, in a field survey on April 5<sup>th</sup> 2000 do hereby state that under requirements of P.A. 74, Michigan P.A. of 1970, the corner points mentioned in lines 1 and 2 above were in conformance with regulations and rules therefore as required in the current manual of survey instructions of the United States Department of the Interior, Bureau of Land Management or by a decree of a Court of Law and/or that the corner points mentioned in lines 3, 4 and 5 above were in conformance with the rules of the Michigan Board of Land Surveyors or by a Decree of a Court of Law; established, re-established, monumented, recovered, found as expressed below:

NOTE: Not more than 2 corners, all in the same town and range, may be recorded on this certificate.

1	A	B	C	D	E	F	G	H	I	J	K	L	N
2		6		5		4		3		2		1	
3													
4		7		8		9		10		11		12	
5													
6		18		17		16		15		14		13	
7													
8		19		20		21		22		23		24	
9													
10		30		29		28		27		26		25	
11													
12		31		32		33		34		35		36	
13													

A. Description of original monument and accessories and/or subsequent restoration:

Corner established by Austin Burt, in 1848.  
Original bearing trees: Hemlock 14" S 53° E 15 links (9.90 ft.)  
Hemlock 16" N 57° W 31 links (20.46 ft.)  
Donald D. Lappala, 12585, on August 28, 1972, restored corner position at reconstituted bearing and distance from the stump hole of first hemlock B.T. and decayed stump of second hemlock B.T. He set a 2" I.D. iron pipe with 3" bronze tablet, stamp to indicated the corner position. He established the following reference objects:  
6" S. Maple - N 24° W - 21.6 ft.; 5" Cedar (Dead & down) - N 61° E - 19.7 ft.;  
13" Hemlock - S 65° W - 10.1 ft.; Metal sign post - S 55° W - 2.2 ft.

B. Description of corner evidence found and/or method applied in restoring or reestablishing corner:

On December 9, 1974, he recorded said corner in U.S.F.S. Liber, Index No. X-9  
6" Y. Birch was added in 1986 - N 57° E - 12.84 ft.  
No original evidence found.

Found D. Lappala monument and accessories.


Act 74 research on file.

ALL GROUP APPROVED  
Richard L. Dean 05/24/00  
COURT REGISTRAR

C. Description of monument for corner and accessories established to perpetuate locating the position of the corner:

From found monument stamped to read: T.48 N., R.44 W.; 1/4; S-32, S-33;  
R.L.S. 12585; 1972, from which I established the following existing and new reference objects:

8" Sugar Maple N 24° W 21.78 ft.  
19" Hemlock S 65° W 10.31 ft.  
10" Yellow Birch N 57° E 12.71 ft. new nail  
10" Maple S 41° E 14.67 ft.  
metal sign post S 55° W 2.2 ft. to face  
(All measurement taken to nail in side of tree)

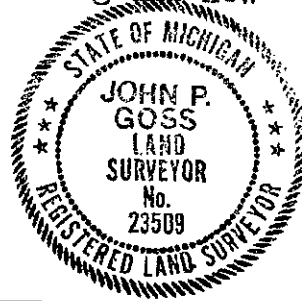

Signed by John P Goss  
Surveyor's Michigan License No. 23509

Date April 5, 2000

U.S.F.S. No. X-9