

LAND CORNER RECORDATION CERTIFICATE
Filing Requirement of Act 74, Mich. P.A. 1970

Register's Office }
Gogebic County } ss.

For corners in

GOGEBIC
(County)

Located In:

Corner Code #

1. Public Land Survey

T48NR44W

F-7

T ___ R ___

T ___ R ___

T ___ R ___

T ___ R ___

2. Property Controlling in Section

S ___

T ___ R ___

3. Miscellaneous Property in Sec.

S ___

T ___ R ___

S ___

T ___ R ___

SURVEY & MONUMENTATION

JAN 05 2001

SECTION

Received for record the
26TH day of MAY
A. D. 2000 at 11:20 o'clock
A m., and recorded in
Liber 7 of CORNERS
on page 343
Cheryl Rupp
Reg. Register of Deeds

Register of Deeds Stamp & File Number

4. Lot No. _____, Recorded Plat _____

5. Private Claims _____

Quarter corner, Sections 16 & 21, T48N, R44W

I, John P. Goss, in a field survey on March 31, 2000 do hereby state that under requirements of P.A. 74, Michigan P.A. of 1970, the corner points mentioned in lines 1 and 2 above were in conformance with regulations and rules therefore as required in the current manual of survey instructions of the United States Department of the Interior, Bureau of Land Management or by a decree of a Court of Law and /or that the corner points mentioned in lines 3, 4 and 5 above were in conformance with the rules of the Michigan Board of Land Surveyors or by a Decree of a Court of Law; established, re-established, monumented, recovered, found as expressed below:

NOTE: Not more than 2 corners, all in the same town and range, may be recorded on this certificate.

A	B	C	D	E	F	G	H	I	J	K	L	M
1												
2	6	5	4	3	2	1						
3												
4	7	8	9	10	11	12						
5												
6	18	17	16	15	14	13						
7												
8	19	20	21	22	23	24						
9												
10	30	29	28	27	26	25						
11												
12	31	32	33	34	35	36						
13												

A. Description of original monument and accessories and/or subsequent restoration:

Corner established by Austin Burt, in 1848. Cedar Post.

Original bearing trees: Cedar 7" S 60° E 10 links (6.60 ft.)
Cedar 10" N 87° W 18 links (11.88 ft.)

Donald D. Lappala, 12585, on August 20, 1968 found corner marked by original point of the original cedar post. also the original bearing trees. He set a 2" I.D. iron pipe with 3" bronze tablet, stamped to indicated the corners position. He established the following reference objects; 7" Cedar - N 25° E 14.6 ft.; 8" Cedar - S 01° W - 27.0 ft.; 5" Cedar - S 67° W - 16.3 ft. He recorded said corner in U.S.F.S. Liber on page N-11, on March 31, 1969.

B. Description of corner evidence found and/or method applied in restoring or reestablishing corner:

Found Lappala Monument and accessories.


Act 74 research on file.

WEEK GROUP APPROVED
Richard P. Deah 05/24/00
COURT REGISTRAR

C. Description of monument for corner and accessories established to perpetuate locating the position of the corner:

From the found monument stamped to read: T.48 N., R.44 W.; 1/4; S-16, S-21; R.L.S. 12585; 1968, from which I established the following existing and new reference objects:

12" Cedar	N 25° E	14.87 ft.
11" Cedar	S 01° W	26.97 ft.
7" Cedar	S 67° W	16.37 ft.
4"x4" Post & sign	N 07° E	1.79 ft. to face
6' Metal rail & sign	S 75° E	1.79 ft. to face

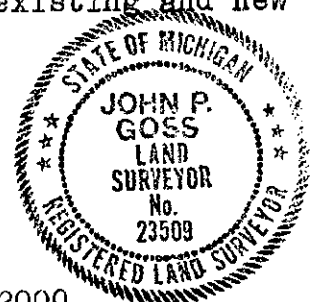

Signed by John P. Goss

Date March 31, 2000

Surveyor's Michigan License No. 23509

U.S.F.S. No. N-11