

**SURVEY &
REMONUMENTATION**

OCT 0 8 1996

COMMISSION

**LAND CORNER RECORDATION CERTIFICATE
Filing Requirement of Act 74, Mich. P.A. 1970**

Register's Office }
Gogebic County } 93.

Received for record the
10TH day of JUNE
A. D. 1996 at 11:00 o'clock
A M., and recorded in
Liber 5 of CORNER
on page 389;
Karmona Collins Deputy
Register of Deeds

Register of Deeds Stamp & File Number

For corners in

<u>Gogebic</u> (County)	Located In:	Corner Code #
1. Public Land Survey	T <u>48N</u> R <u>44W</u>	<u>G-6</u>
	T _____ R _____	_____
	T _____ R _____	_____
	T _____ R _____	_____
2. Property Controlling in Section	S _____ T _____ R _____	_____
	S _____ T _____ R _____	_____
3. Miscellaneous Property in Sec.	S _____ T _____ R _____	_____
	S _____ T _____ R _____	_____

4. Lot No. _____, Recorded Plat _____
5. Private Claims _____

$\frac{1}{4}$ Cor 15 & 16; T.48 N., R.44 W.

I, Richard L. Drahn in a field survey on May 28, 1996, do hereby certify that under requirements of P.A. 74, Michigan P.A. of 1970, the corner points mentioned in lines 1 and 2 above were in conformance with regulations and rules therefore as required in the current manual of survey instructions of the United States Department of the Interior, Bureau of Land Management or by a decree of a Court of Law and/or that the corner points mentioned in lines 3, 4 and 5 above were in conformance with the rules of the Michigan Board of Land Surveyors or by a Decree of a Court of Law; established, re-established, monumented, re-monumented, recovered, found as expressed below:

NOTE: Not more than 4 corners, all in the same town and range, may be recorded on this certificate.

A. Description of original monument and accessories and/or subsequent restoration:

Corner established by Austin Burt on Sept. 8, 1848. Original B.T.s --- Hemlock 7" N.33 W. 15 links (9.90') --- Fir 7" S.32 E. 10 links (6.60') --- Corner restored by Donald D. Lappala, RLS 12585 from the remains of the two original bearing trees and a natural feature tie north on 8/20/68. He set a 2" dia. iron pipe with a 3" stamped brass cap and the following new bearing trees. --- 8" (9") Cedar N.46 W. (N.43 W.) 30.5' (30.60') --- 5" (8") Cedar N.80 E. (N.83 E.) 22.1' (22.09') --- 7" (9") Cedar S.09 E. (S.08 E.) 15.7' (15.68') ---
Corner recorded in Gogebic County in USFS Liber, Page L-13 on 3/31/69.

B. Description of corner evidence found and/or method applied in restoring or reestablishing corner:

Act 74 research form on file with Gogebic County records.

Recovered the monument as described and the bearing trees as noted in parentheses above. Fragments of hemlock bark are all that remain of the original bearing trees.


A	B	C	D	E	F	G	H	I	J	K	L	M
2	6	5	4	3	2	1						
3												
4	7	8	9	10	11	12						
5												
6	18	17	16	15	14	13						
7												
8	19	20	21	22	23	24						
9												
10	30	29	28	27	26	25						
11												
12	31	32	33	34	35	36						
13												

PEER GROUP APPROVED
Richard L. Drahn 6/6/96
COUNTY REPRESENTATIVE

C. Description of monument for corner and accessories established to perpetuate locating the position of the corner:

Bearing objects referenced:

- | | | |
|-------------------------|---------|-------|
| 4" X 4" Cedar sign post | S.76 W. | 2.45' |
| 6' Steel sign rail | S.08 E. | 2.95' |

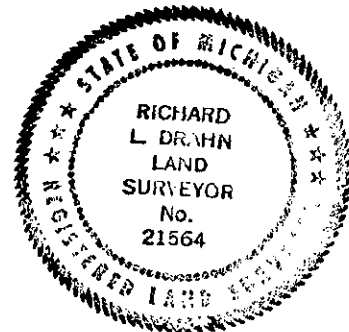

Signed by Richard L. Drahn Date May 30, 1996

Surveyor's Michigan License No. 21564