

LAND CORNER RECORDATION CERTIFICATE
Filing Requirement of Act 74, Mich. P.A. 1970

Register's Office }

Received for record the
22ND day of JUNE
A. D. 2000 at 1:25 o'clock
P m., and recorded in
Book 8 of CORNER
page 5
Cheryl Ruppel, Reg.
Register of Deeds

Register of Deeds Stamp & File Number

For corners in

GOGBEIC

(County)

Located in:

Corner Code #

1. Public Land Survey

T48N R 44W

G-9

T ___ R ___

T ___ R ___

T ___ R ___

SURVEY &

MONUMENTATION

2. Property Controlling in Section

S ___ T ___ R ___

S ___ T ___ R ___

JAN 05 2001

3. Miscellaneous Property in Sec.

S ___ T ___ R ___

S ___ T ___ R ___

SECTION

4. Lot No. _____, Recorded Plat _____

5. Private Claims _____

Section corner, Sections 21, 22, 27 & 28, T48N, R44W

I, John P. Goss, in a field survey on June 5, 2000 do hereby state that under requirements of P.A. 74, Michigan P.A. of 1970, the corner points mentioned in lines 1 and 2 above were in conformance with regulations and rules therefore as required in the current manual of survey instructions of the United States Department of the Interior, Bureau of Land Management or by a decree of a Court of Law and for that the corner points mentioned in lines 3, 4 and 5 above were in conformance with the rules of the Michigan Board of Land Surveyors or by a Decree of a Court of Law; established, re-established, monumented, recovered, found as expressed below:

NOTE: Not more than 2 corners, all in the same town and range, may be recorded on this certificate.

| | A | B | C | D | E | F | G | H | I | J | K | L | M |
|----|----|---|----|---|----|---|----|---|----|---|----|---|---|
| 1 | | | | | | | | | | | | | |
| 2 | 6 | | 5 | | 4 | | 3 | | 2 | | 1 | | |
| 3 | | | | | | | | | | | | | |
| 4 | 7 | | 8 | | 9 | | 10 | | 11 | | 12 | | |
| 5 | | | | | | | | | | | | | |
| 6 | 18 | | 17 | | 16 | | 15 | | 14 | | 13 | | |
| 7 | | | | | | | | | | | | | |
| 8 | 19 | | 20 | | 21 | | 22 | | 23 | | 24 | | |
| 9 | | | | | | | | | | | | | |
| 10 | 30 | | 29 | | 28 | | 27 | | 26 | | 25 | | |
| 11 | | | | | | | | | | | | | |
| 12 | 31 | | 32 | | 33 | | 34 | | 35 | | 36 | | |
| 13 | | | | | | | | | | | | | |

A. Description of original monument and accessories and/or subsequent restoration:

Corner established by Austin Burt, in 1848.

Original bearing trees: Sugar Maple 14" S 24° E 18 links (11.88 ft.)
Sugar Maple 14" N 75° W 31 links (20.46 ft.)

Donald D. Lappala, 12585, on Sept. 6, 1972, restored corner position from the remains of the two original bearing trees and to line trees North and West. He set a 2" by 5' iron pipe with 3" bronze tablet. He established the following reference objects:

6" Yellow Birch N 60° W 14.1 ft.; 8" Sugar Maple N 80° E 10.6 ft.
7" Sugar maple S 10° W 28.3 ft.; metal sign post S 25° W 2.0 ft.

B. Description of corner evidence found and/or method applied in restoring or reestablishing corner:

On December 9, 1974, he recorded said corner in U.S.F.S. Liber, Index R-13.

I recovered the monument and accessories as described above.


Act 74 research on file.

BEEN KNOWN APPROVED
Richard P. Decker 6/21/00
COURT RECORDED

C. Description of monument for corner and accessories established to perpetuate locating the position of the corner:

From the found monument I established the following existing and new reference objects:

9" Yellow Birch N 60° W 14.45 ft.
11" Sugar Maple N 80° E 28.26 ft.
7" Sugar Maple S 10° W 10.62 ft.
13" Maple S 54° E 29.52 ft.
A metal sign post S 25° W 2.14 ft. to face
(All measurements taken to nail in side of tree)

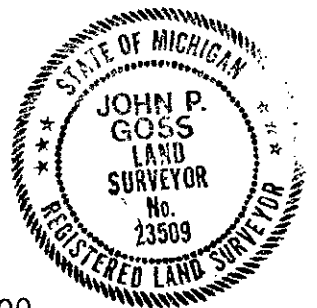

Signed by John P. Goss

Date June 5, 2000

Surveyor's Michigan License No. _____

23509

U.S.F.S. No. R-13