

LAND CORNER RECORDATION CERTIFICATE
 Filing Requirement of Act 74, Mich. P.A. 1970

Register's Office }
 Gogebic County } ss.

For corners in

GOGEBIC
 (County)

Located In: Corner Code #

1. Public Land Survey

T48N R44W G-10

T___ R___
 T___ R___ **SURVEY &**
 T___ R___ **MONUMENTATION**

2. Property Controlling in Section

S___ T___ R___
 S___ T___ R___

3. Miscellaneous Property in Sec.

S___ T___ R___
 S___ T___ R___

JAN 05 2001

SECTION

Received for record the
22ND day of JUNE
A. D. 1900 at 1:25 o'clock
P m., and recorded in
 Liber 8 of CORNERS
 on page 6
Cheryl P. Dep.
 Register of Deeds

Register of Deeds Stamp & File Number

4. Lot No. _____, Recorded Plat _____

5. Private Claims _____

Quarter section, Sections 27 & 28, T48N, R44W

I, John P. Goss, in a field survey on June 12, 2000 do hereby state that under requirements of P.A. 74, Michigan P.A. of 1970, the corner points mentioned in lines 1 and 2 above were in conformance with regulations and rules therefore as required in the current manual of survey instructions of the United States Department of the Interior, Bureau of Land Management or by a decree of a Court of Law and/or that the corner points mentioned in lines 3, 4 and 5 above were in conformance with the rules of the Michigan Board of Land Surveyors or by a Decree of a Court of Law; established, re-established, monumented, recovered, found as expressed below:

A	B	C	D	E	F	G	H	I	J	K	L	M
1												
2	6		5		4		3		2		1	
3												
4	7		8		9		10		11		12	
5												
6	18		17		16		15		14		13	
7												
8	19		20		21		22		23		24	
9												
10	30		29		28		27		26		25	
11												
12	31		32		33		34		35		36	
13												

NOTE: Not more than 2 corners, all in the same town and range, may be recorded on this certificate.

A. Description of original monument and accessories and/or subsequent restoration:

Corner established by Austin Burt, in 1848.

Original bearing trees: Yellow Birch 12" S 45° W 36 links (23.76 ft.)
 Sugar Maple 14" N 30° E 32 links (21.12 ft.)

Donald D. Lappala, 12585, on Sept. 8, 1972, restored corner position at record bearing and distance from the remains of the two original bearing trees. The Y. Birch stump & decayed sugar maple windwall and natural features, a line tree south of corner. He set a 2" by 5' iron pipe with 3" bronze tablet. He established the following reference objects:

11" Yellow Birch N 17° W 7.2 ft.; 6" Sugar Maple S 66° E 33.7 ft.;

B. Description of corner evidence found and/or method applied in restoring or reestablishing corner:

8" Sugar Maple S 21° E 39.2 ft.; A metal sign post West 2.2 ft.

On December 9, 1974, he recorded said corner in U.S.F.S. Liber, Index T-13


I recovered the monument and accessories as described above.

Act 74 research on file.

DEER GROUP APPROVED
Richard P. Decker 6/21/00
 COUNTY SUPERVISOR

C. Description of monument for corner and accessories established to perpetuate locating the position of the corner:
 From the found monument I established the following existing and new reference objects:

14" Yellow Birch N 17° W 7.21 ft.
 8" Sugar Maple S 66° E 33.80 ft.
 12" Sugar Maple S 21° E 39.25 ft.
 12" Sugar Maple S 62° W 12.83 ft.
 A metal sign post West 2.26 ft. to face
 (All measurements taken to nail in side of tree)

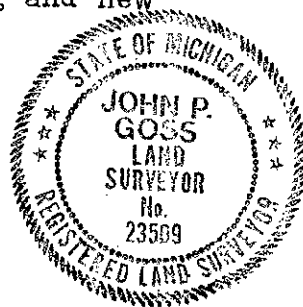

Signed by John P. Goss

Date June 12, 2000

Surveyor's Michigan License No. 23509

U.S.F.S. No. T-13