

SURVEY & REMONUMENTATION

JAN 22 1998

SECTION

LAND CORNER RECORDATION CERTIFICATE
Filing Requirement of Act 74, Mich. P.A. 1970


Register's Office }
 Gogebic County } ss.

Received for record the
2nd day of DECEMBER
 A. D. 1997 at 10:35 o'clock
A m., and recorded in
 Liber 6 of CORNERS
 on page 285
Ramona Collins Deputy
 Register of Deeds

For corners in <u>Gogebic</u> <small>(County)</small>	Located In:	Corner Code #
1. Public Land Survey	T <u>48N</u> R <u>44W</u>	<u>I-3</u>
	T _____ R _____	_____
	T _____ R _____	_____
	T _____ R _____	_____
2. Property Controlling in Section	S _____ T _____ R _____	_____
	S _____ T _____ R _____	_____
3. Miscellaneous Property in Sec.	S _____ T _____ R _____	_____
	S _____ T _____ R _____	_____
4. Lot No. _____, Recorded Plat _____		
5. Private Claims _____		

Register of Deeds Stamp & File Number

Section Corner 2, 3, 10 & 11; T.48 N., R.44 W.

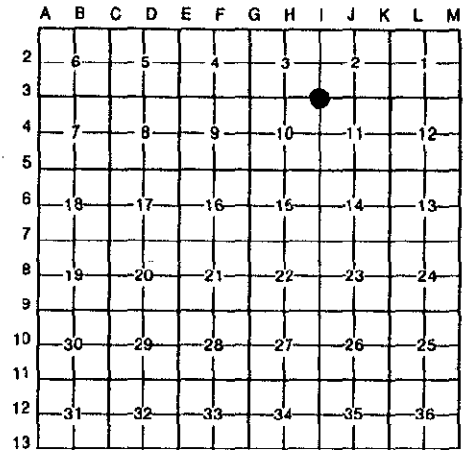

I, Richard L. Drahn in a field survey on November 14, 19 97, do hereby certify that under requirements of P.A. 74, Michigan P.A. of 1970, the corner points mentioned in lines 1 and 2 above were in conformance with regulations and rules therefore as required in the current manual of survey instructions of the United States Department of the Interior, Bureau of Land Management or by a decree of a Court of Law and/or that the corner points mentioned in lines 3, 4 and 5 above were in conformance with the rules of the Michigan Board of Land Surveyors or by a Decree of a Court of Law; established, re-established, monumented, re-monumented, recovered, found as expressed below:

NOTE: Not more than 4 corners, all in the same town and range, may be recorded on this certificate.

A. Description of original monument and accessories and/or subsequent restoration:

Corner established by Austin Burt on September 5, 1848. Original B.T.s --- Sugar 12" S.62 W. 25 links (16.5') --- Lynn 12" N.72 E. 25 links (16.5') ---

Corner restored on 11/7/83 by Richard L. Drahn (21564) from the stump holes of the original B.T.s, line trees and natural features. He set a 2" X 30" aluminum pipe with a 3 1/4" stamped aluminum cap and the following B.T.s:

- 12" Sugar Maple N.35 W. 43.76'
- 9" Sugar Maple N.74 E. 9.24'
- 18" Sugar Maple S.51 W. 8.88'
- 6' Steel rail S.75 W. 1.8'

B. Description of corner evidence found and/or method applied in restoring or reestablishing corner:

Corner recorded in Gogebic County in Liber 2, Page 557 on 1/26/84.

Corner found marked by the monument as described and the following B.T.s by Richard L. Drahn:

- 15" Sugar Maple N.32 W. 43.76'
- 11" Sugar Maple N.84 E. 9.29'
- 21" Sugar Maple S.54 W. 9.04'
- 6' Steel rail S.78 W. 1.76'

No evidence remains of the original B.T.s.

Research form on file with Gogebic County records.

Description of monument for corner and accessories established to perpetuate locating the position of the corner:

From the above described monument I referenced the following:

- 10" Sugar Maple N.12E. 38.34'

PEER GROUP APPROVED
Richard L. Drahn 12/1/97
 COUNTY _____



Witnessed by Richard L. Drahn Date November 25, 1997

Surveyor's Michigan License No. 21564