

MAY 16 1997

COMMISSION

LAND CORNER RECORDATION CERTIFICATE
Filing Requirement of Act 74, Mich. P.A. 1970

Register's Office }
Gogebic County } ss.

For corners in

Gogebic
(County)

Located In:

Corner Code #

- 1. Public Land Survey T 48N R 44W I-7
2. Property Controlling in Section S T R
3. Miscellaneous Property in Sec. S T R

Received for record the
17th day of OCTOBER
A. D. 1996 at 9:50 o'clock
A m., and recorded in
Liber 5 of CORNERS

page 67
Ramona Collins, Deputy
Register of Deeds

Register of Deeds Stamp & File Number

- 4. Lot No. , Recorded Plat
5. Private Claims

Sec. Cor. 14, 15, 22 & 23; T.48 N., R.44 W.

I, Richard L. Drahn in a field survey on October 14, 1996
do hereby certify that under requirements of P.A. 74, Michigan P.A. of 1970, the corner points mentioned
in lines 1 and 2 above were in conformance with regulations and rules therefore as required in the
current manual of survey instructions of the United States Department of the Interior, Bureau of Land
Management or by a decree of a Court of Law and/or that the corner points mentioned in lines 3, 4 and 5
above were in conformance with the rules of the Michigan Board of Land Surveyors or by a Decree of a
Court of Law; established, re-established, monumented, re-monumented, recovered, found as
expressed below:

Grid table with columns A-M and rows 2-13. A dot is marked at row 7, column H.

NOTE: Not more than 4 corners, all in the same town and range, may be recorded
on this certificate.

A. Description of original monument and accessories and/or subsequent restoration:

Corner established by Austin Burt on Sept. 6, 1848. Original B.T.s ---
Elm 12" S.31 W. 26 links (17.16') --- Elm 10" N.35 E. 15 links (9.90')---
Corner re-established by Richard L. Drahn, RLS 21564, on 7/26/89 using
proportionate methods. He set a 2" dia. iron pipe monument with a stamped
brass cap and the following new B.T.s: --- 7" (9") Silver Maple N.65 W.
(N.67 W.) 14.98' (15.02') --- 10" (11") Black Cherry N.65 E. (N.64 E.)
23.13' (23.14') --- 12" (15") Silver Maple S.62 E. (S.59 E.) 13.44'
(13.44') --- 6' Steel Rail S.27 E. (S.27 E.) 2.1' (2.09') ---
Corner recorded in Gogebic County in Liber 3, Page 310 on 1/23/90.

B. Description of corner evidence found and/or method applied in restoring or reestablishing corner:

Act 74 research form on file with Gogebic County records.


Recovered the monument as described and the bearing trees as noted in
parentheses above. No evidence remains of the original B.T.s.

C. Description of monument for corner and accessories established to perpetuate locating the position of the corner:

Bearing tree referenced:

5" Black Ash S.23 E. 7.22'

PEER GROUP APPROVED
Richard L. Drahn 10/16/96
COUNTY REPRESENTATIVE

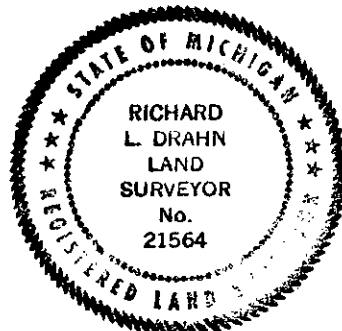

Signed by Richard L. Drahn Date October 15, 1996

Surveyor's Michigan License No. 21564