

SURVEY & REMONUMENTATION

JAN 22 1998

SECTION

LAND CORNER RECORDATION CERTIFICATE
Filing Requirement of Act 74, Mich. P.A. 1970

Register's Office } ss.
Gogebic County }

Received for record the
2ND day of DECEMBER
A. D. 1997 at 10:35 o'clock
A m., and recorded in
Liber 6 of CORNERS
on page 286
Ramona Collins Deputy
Register of Deeds

For corners in

<u>Gogebic</u> (County)	Located In:	Corner Code #
1. Public Land Survey	T <u>48N</u> R <u>44W</u>	<u>J-3</u>
	T _____ R _____	_____
	T _____ R _____	_____
	T _____ R _____	_____
2. Property Controlling in Section	S _____ T _____ R _____	_____
	S _____ T _____ R _____	_____
3. Miscellaneous Property in Sec.	S _____ T _____ R _____	_____
	S _____ T _____ R _____	_____

Register of Deeds Stamp & File Number

4. Lot No. _____, Recorded Plat _____
5. Private Claims _____

$\frac{1}{4}$ Corner 2 & 11; T.48 N., R.44 W.

	A	B	C	D	E	F	G	H	I	J	K	L	M
2	6	5	4	3	2	1							
3										●			
4	7	8	9	10	11	12							
5													
6	18	17	16	15	14	13							
7													
8	19	20	21	22	23	24							
9													
10	30	29	28	27	26	25							
11													
12	31	32	33	34	35	36							
13													

I, Richard L. Drahn in a field survey on November 14, 1997, do hereby certify that under requirements of P.A. 74, Michigan P.A. of 1970, the corner points mentioned in lines 1 and 2 above were in conformance with regulations and rules therefore as required in the current manual of survey instructions of the United States Department of the Interior, Bureau of Land Management or by a decree of a Court of Law and/or that the corner points mentioned in lines 3, 4 and 5 above were in conformance with the rules of the Michigan Board of Land Surveyors or by a Decree of a Court of Law; established, re-established, monumented, re-monumented, recovered, found as expressed below:

NOTE: Not more than 4 corners, all in the same town and range, may be recorded on this certificate.

A. Description of original monument and accessories and/or subsequent restoration:

Corner established by Austin Burt on September 5, 1848. Original B.T.s --- Cedar 10" S.89 W. 3.00 chains (198.0') --- Tamarack 16" N.86 W. 2.98 chains (196.68') ---

Corner re-established on 2/29/84 by Richard L. Drahn (21564) by single proportionate methods. He set a 3/4" X 7' aluminum rod with a 3 1/4" stamped aluminum cap and the following new B.T.s:

- 12" Black Cherry N.35 E. 75.25'
- 15" Elm S.34 E. 132.38'
- 6" Ash S.76 W. 142.40'

B. Description of corner evidence found and/or method applied in restoring or reestablishing corner:

- 6' Steel rail N.49 E. 1.8'

Corner recorded in Gogebic County in Liber 2, Page 565 on 2/15/84.

Corner found marked by the monument as described and the following B.T.s:

- 13" Black Cherry N.33 E. 75.28'
- Elm (dead and down)
- 7" Black Ash S.74 W. 142.44'
- 6' Steel rail N.48 E. 1.72'

No evidence remains of the original B.T.s.


Research form on file with Gogebic County records.

C. Description of monument for corner and accessories established to perpetuate locating the position of the corner:

From the above described monument I referenced the following:

- 6' Steel sign rail S.35 E. 4.00'
- 6' Steel sign rail S.30 W. 3.93'

PEER GROUP APPROVED
Richard L. Drahn 12/1/97
COUNTY _____

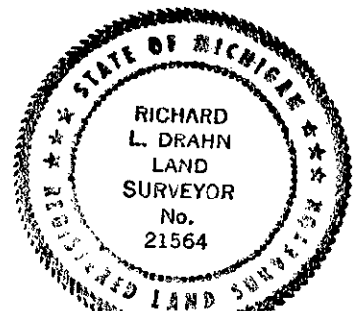

Signed by Richard L. Drahn Date November 25, 1997

Surveyor's Michigan License No. 21564