

11/13/96

COMMISSION

LAND CORNER RECORDATION CERTIFICATE
Filing Requirement of Act 74, Mich. P.A. 1970

Register's Office }
Gogebic County } ss.

Received for record the
17th day of OCTOBER
A. D. 1996 at 9:50 o'clock
A m., and recorded in
Liber 6 of CORNERS

on page 68
Ramona Collins, Deputy
Register of Deeds

Register of Deeds Stamp & File Number

For corners in

Gogebic
(County)

Located In:


Corner Code #

Table with 3 columns: Survey Type, Located In (T/R/S), and Corner Code #. Includes entries for Public Land Survey, Property Controlling in Section, and Miscellaneous Property in Sec.

- 4. Lot No. , Recorded Plat
5. Private Claims

1/4 Corner 11 & 14; T.48 N., R.44 W.

Richard L. Drahn in a field survey on October 8, 1996, do hereby certify that under requirements of P.A. 74, Michigan P.A. of 1970, the corner points mentioned in lines 1 and 2 above were in conformance with regulations and rules therefore as required in the current manual of survey instructions of the United States Department of the Interior, Bureau of Land Management or by a decree of a Court of Law and/or that the corner points mentioned in lines 3, 4 and 5 above were in conformance with the rules of the Michigan Board of Land Surveyors or by a Decree of a Court of Law; established, re-established, monumented, re-monumented, recovered, found as expressed below.

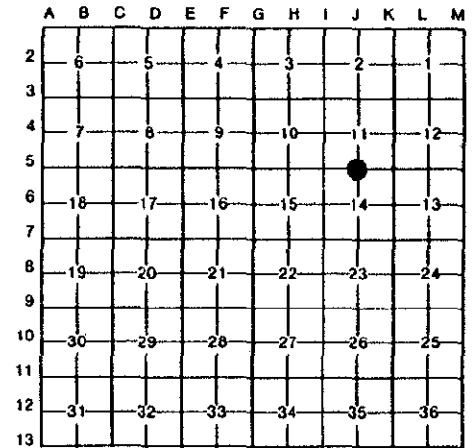

NOTE: Not more than 4 corners, all in the same town and range, may be recorded on this certificate.

A. Description of original monument and accessories and/or subsequent restoration:

Corner established by Austin Burt on Sept. 5, 1848. Original B.T.s --- Cedar 14" S.50 W. 22 links (14.52') --- Cedar 12" N.68 E. 16 links (10.56') Corner restored by Donale D. Lappala, RLS 12585 on 9/04/68 from the remains of the two original B.T.s, one still scribed. He set a 2" iron pipe monument with a 3" stamped brass cap and the following new B.T.s --- 9" Yellow Birch (11") N.02 W. (N.01 E.) 11.7' (11.72') --- 8" (9") Hemlock S.58 E. (S.56 E.) 27.5' (27.48') --- 8" (12") Cedar S.06 E. (S.06 E.) 26.3' (26.21')

Corner recorded in Gogebic County in USFS Liber, Page J-19 on 3/31/69.

B. Description of corner evidence found and/or method applied in restoring or reestablishing corner:

Act 74 research form on file with Bobevic County Records.

Recovered the monument as described and the bearing trees as noted in parentheses above. No evidence remains of the first original B.T. A 6' high Cedar stub with GLO scribing and measuring notch agrees with the field notes for the second GLO B.T.

PEER GROUP APPROVED

Richard L. Drahn 10/16/96
COUNTY REPRESENTATIVE

C. Description of monument for corner and accessories established to perpetuate locating the position of the corner:

Bearing objects referenced:

Table with 4 columns: Object, Bearing, Distance. Includes entries for Steel sign post, Hemlock, and Cedar.



Signed by Richard L. Drahn

Date October 9, 1996

Surveyor's Michigan License No. 21564