

LAND CORNER MONUMENTS


JAN 20 1999

T. 48 N., R. 44 W.

SECTION

WAKEFIELD TOWNSHIP

State
Index

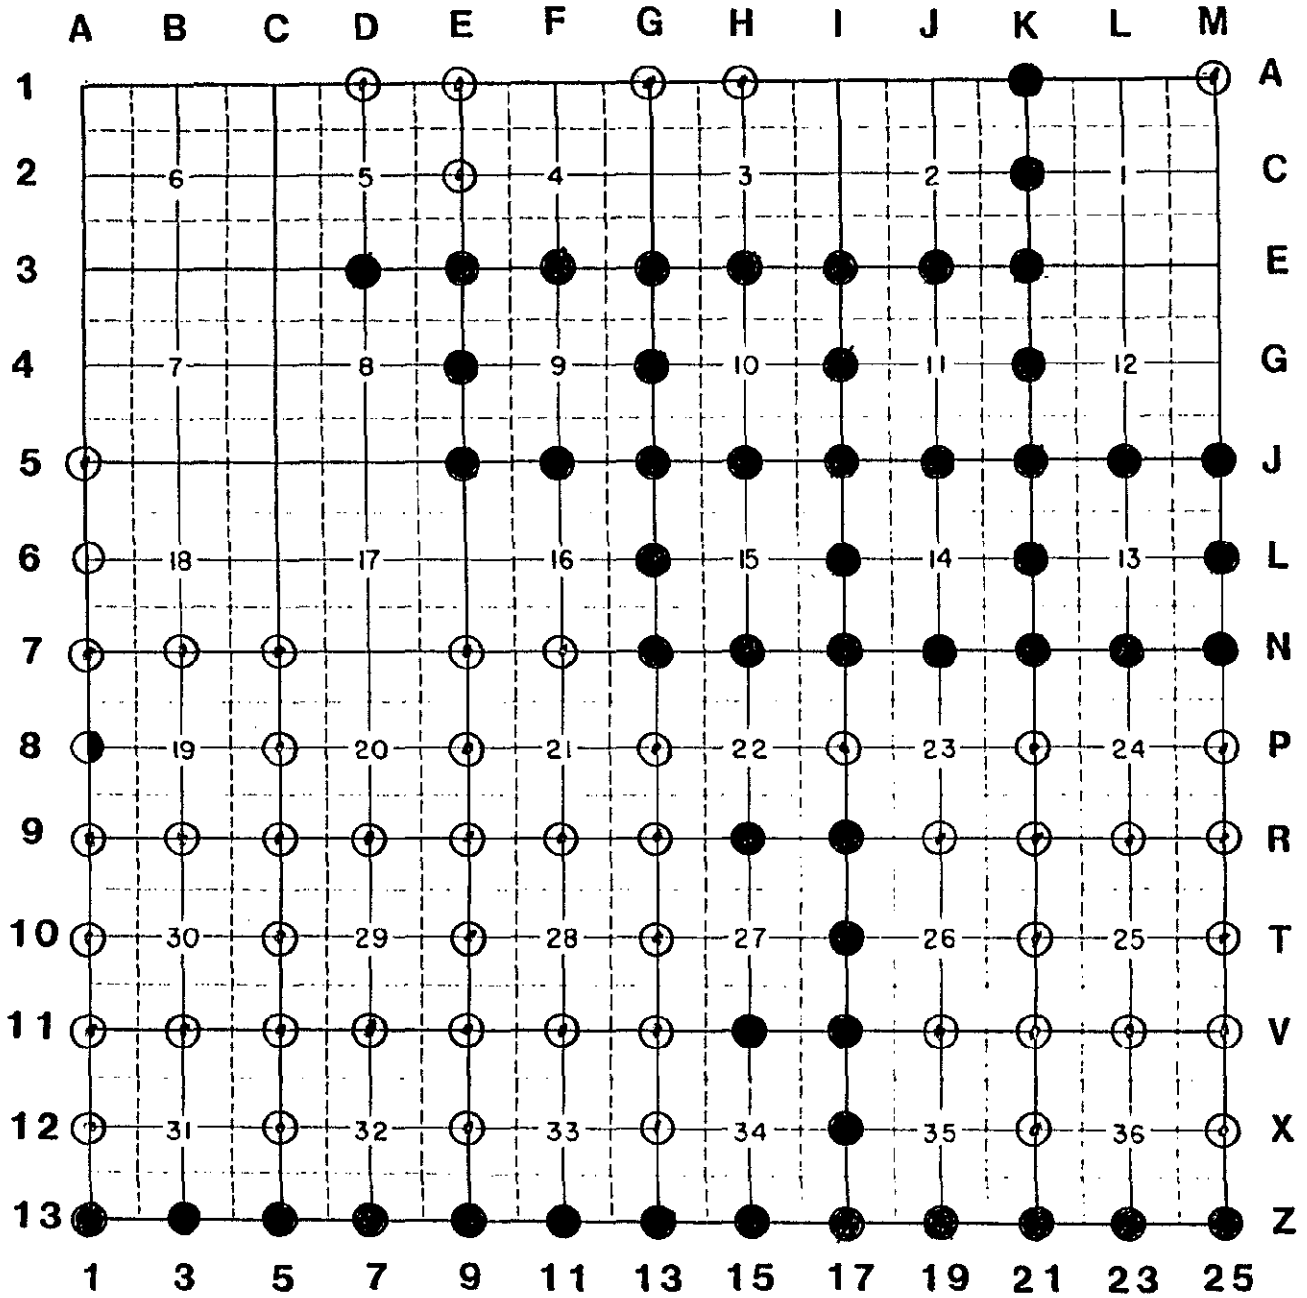

AS OF 12/31/98

LEGEND

Federal
Index

- GLO Corners researched
- ⊙ GLO Corners monumented, not approved
- ⊗ GLO Corners approved
- GLO Corners approved & reported to State

T. 48 N., R. 44 W.