

MAR 02 2000

LAND CORNER RECORDATION CERTIFICATE  
Filing Requirement of Act 74, Mich. P.A. 1970

Register's Office }  
Gogebic County } ss.

SECTION

Received for record the  
26<sup>TH</sup> day of AUGUST  
A. D. 1999 at 1:40 o'clock  
P m., and recorded in  
Liber 7 of CORNERS  
on page 226  
Ramona Collins, Deputy  
Register of Deeds

For corners in


<u>Gogebic</u> (County)	Located In:	Corner Code #
1. Public Land Survey	<u>T 48N R 45W.</u>	<u>A-1</u>
	<u>T 48N R 46W</u>	<u>M-1</u>
	<u>T 49N R 45W</u>	<u>A-13</u>
	<u>T 49N R 46W</u>	<u>M-13</u>
2. Property Controlling in Section	S ___ T ___ R ___	___
	S ___ T ___ R ___	___
3. Miscellaneous Property in Sec.	S ___ T ___ R ___	___
	S ___ T ___ R ___	___

Register of Deeds Stamp & File Number

4. Lot No. \_\_\_\_\_, Recorded Plat \_\_\_\_\_  
5. Private Claims \_\_\_\_\_

Section Corner 6, 1, 31 & 36; T.48-49 N., R.45-46 W.

I, Richard L. Drahn, in a field survey on August 22, 1999 do hereby state that under requirements of P.A. 74, Michigan P.A. of 1970, the corner points mentioned in lines 1 and 2 above were in conformance with regulations and rules therefore as required in the current manual of survey instructions of the United States Department of the Interior, Bureau of Land Management or by a decree of a Court of Law and /or that the corner points mentioned in lines 3, 4 and 5 above were in conformance with the rules of the Michigan Board of Land Surveyors or by a Decree of a Court of Law; established, re-established, monumented, recovered, found as expressed below:

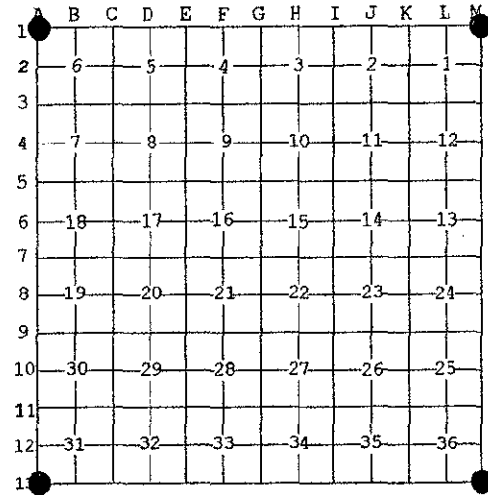

NOTE: Not more than 2 corners, all in the same town and range, may be recorded on this certificate.

A. Description of original monument and accessories and/or subsequent restoration:

Original corner established by Austin Burt on 9/9/1847. Original bearing trees:  
Maple 14" S.65° E. 24 links (15.84')  
Maple 14" N.69° W. 35 links (23.10')

B. Description of corner evidence found and/or method applied in restoring or reestablishing corner:

I restored the corner position at record bearing and distance from the stump holes of the two original bearing trees.  
Distance checks to recovered quarter corners 36.05 chains east and 39.88 chains south.  
A 3/4" X 2" iron pipe set by compass and chain by the Gogebic County Forestry Commission bears S.89° E., 10.8 feet.  
Corner research on file with Gogebic County records.

C. Description of monument for corner and accessories established to perpetuate locating the position of the corner:

At the corner position I set a 2" x 30" aluminum pipe monument with a 3 1/4" stamped aluminum cap and the following new B.T.s (all measurements taken to a nail in side of tree):

Sugar Maple	6"	N.67° E.	23.95'
Red Maple	10"	N.05° W.	28.00'
Red Maple	12"	S.48 °W.	19.70'
Steel sign rail	6'	N.83° W.	2.01'

DEED GROUP APPROVED  
Richard L. Drahn 8/24/99  
COUNTY REGISTER



Signed by Richard L. Drahn Date August 23, 1999

Surveyor's Michigan License No. 21564

FORM APPROVED BY MICHIGAN STATE BOARD OF PROFESSIONAL SURVEYORS, JAN. 28, 1971  
REVISED MAY 14, 1978  
REVISED JAN., 1983  
REVISED OCT., 1986