SURVEY & REMONUMENTATION

SEP 0 8 1998

SECTION

LAND CORNER RECORDATION CERTIFICATE

Filing Requirement of Act 74, Mich. P.A. 1970

Register's Office } ss.
Gogebic County }

Received for record the 20th day of AUGUST A. D. 1998 at 1:20 o'clock P m., and recorded in Liber 7 of CORNERS on page 49.

Ramona Collins Deputy
Register of Deeds

Register of Deeds Stamp & File Number

For corners in

Gogebic (County)

	Located In:	Corner Code ##
1. Public Land Survey	T 48N R 45W	A-5
	T ___ R ___	
	T ___ R ___	
	T 48N R 46W	M-5
2. Property Controlling	S ___	
in Section	S ___ T ___ R ___	
3. Miscellaneous	S ___ T ___ R ___	
Property in Sec.	S ___ T ___ R ___	

4. Lot No. _____ , Recorded Plat _____
5. Private Claims _____

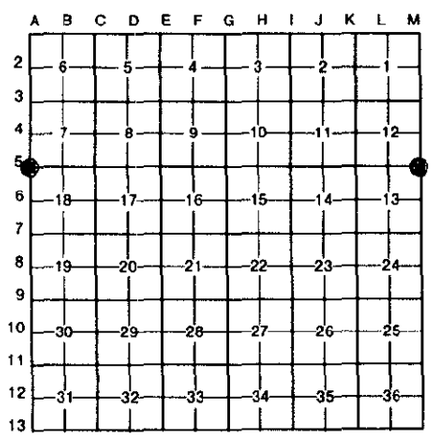

Section Corner 7, 18, 12 & 13; T.48 N., R.45-46 W

I, Richard L. Drahn in a field survey on August 5, , 19 98 , do hereby certify that under requirements of P.A. 74, Michigan P.A. of 1970, the corner points mentioned in lines 1 and 2 above were in conformance with regulations and rules therefore as required in the current manual of survey instructions of the United States Department of the Interior, Bureau of Land Management or by a decree of a Court of Law and/or that the corner points mentioned in lines 3, 4 and 5 above were in conformance with the rules of the Michigan Board of Land Surveyors or by a Decree of a Court of Law; established, re-established, monumented, re-monumented, recovered, found as expressed below:

NOTE: Not more than 4 corners, all in the same town and range, may be recorded on this certificate.

A. Description of original monument and accessories and/or subsequent restoration:

Corner established by John Burt on 9/10/1847. Original B.T.s --- Hemlock 12" S.50 E. 4 links (2.64') --- Sugar 12" N.48 W. 8 links (5.28') ---

Corner restored by Richard L. Drahn, RLS 21564, on 7/24/84 from the remains of the Sugar B.T., and from line trees and natural features north, south, east and west. He set a 2" X 30" alum. pipe with a 3¼" alum. cap, stamped to indicate the corner position and the following new B.T.s:

8"	Yellow Birch	N.21 W.	17.07'
17"	Hemlock	N.54 E.	26.72'
9"	Yellow Birch	S.61 W.	28.80'

B. Description of corner evidence found and/or method applied in restoring or reestablishing corner:

6'	Steel sign rail	S.33 W.	2.0'

Corner recorded in Gogebic County Liber 2, Page 707 on 12/10/84.

Corner research on file with Gogebic County records.

Recovered the monument as described and the bearing trees as follows:

10"	Yellow Birch	N.20 W.	17.11'
17"	Hemlock (dead)	N.56 E.	26.75'
11"	Yellow Birch	S.59 W.	28.74'
6'	Steel sign rail	S.35 W.	1.95'

A decayed Sugar Maple stump still remains from the original B.T.s.

C. Description of monument for corner and accessories established to perpetuate locating the position of the corner:

New bearing tree referenced:

7"	Sugar Maple	N.74 E.	37.85'

PEER GROUP APPROVED
Richard L. Drahn 8/19/98
COUNTY REPRESENTATIVE

STATE OF MICHIGAN
RICHARD L. DRAHN
LAND SURVEYOR
No. 21564
REGISTERED LAND SURVEYOR

Signed by Richard L. Drahn Date August 14, 1998

Surveyor's Michigan License No. 21564

FORM APPROVED BY MICHIGAN STATE BOARD OF LAND SURVEYORS, JAN. 28, 1971
REVISED MAY 14, 1975
REVISED JAN., 1983

USFS J-1