SURVEY & REMONUMENTATION

SEP 0 8 1998

SECTION

LAND CORNER RECORDATION CERTIFICATE
Filing Requirement of Act 74, Mich. P.A. 1970

Register's Office } ss.
Gogebic County }

Received for record the 18TH day of JUNE A. D. 19 98 at 1:30 o'clock P m., and recorded in Liber 7 of CORNERS on page 7.

Ramona L. Collins Dep.
Register of Deeds

Register of Deeds Stamp & File Number

For corners in

Gogebic (County)

	Located In:	Corner Code ##
1. Public Land Survey	T 48N R 45W	A-11
	T ___ R ___	
	T ___ R ___	
	T 48N R 46W	M-11
2. Property Controlling	S ___ T ___ R ___	
in Section	S ___ T ___ R ___	
3. Miscellaneous	S ___ T ___ R ___	
Property in Sec.	S ___ T ___ R ___	

4. Lot No. _____, Recorded Plat _____
5. Private Claims _____

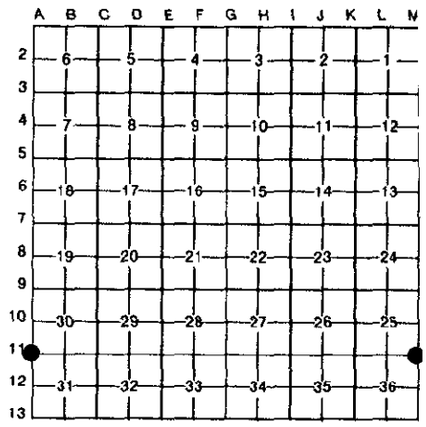

Section Corner 30, 31, 25 & 36; T.48 N., R.45-46 W.

I, Richard L. Drahn in a field survey on June 15, 19 98, do hereby certify that under requirements of P.A. 74, Michigan P.A. of 1970, the corner points mentioned in lines 1 and 2 above were in conformance with regulations and rules therefore as required in the current manual of survey instructions of the United States Department of the Interior, Bureau of Land Management or by a decree of a Court of Law and/or that the corner points mentioned in lines 3, 4 and 5 above were in conformance with the rules of the Michigan Board of Land Surveyors or by a Decree of a Court of Law; established, re-established, monumented, re-monumented, recovered, found as expressed below:

NOTE: Not more than 4 corners, all in the same town and range, may be recorded on this certificate.

A. Description of original monument and accessories and/or subsequent restoration:

Corner established by John Burt on 9/10/1847. Original B.T.s ---Hemlock 20" S.54 E. 42 links (27.72') --- Sugar 10" N.48 W. 19 links (12.54') --- Corner restored by Richard L. Drahn (21564) from the remains of the two original B.T.s and line trees north and south. He set a 2" X 30" aluminum pipe with a 3¼" stamped aluminum cap and the following new B.T.s:

6"	Sugar Maple	N.62 W.	25.90'
8"	Sugar Maple	S.88 E.	22.21'
9"	Sugar Maple	S.35 W.	27.21'
6'	Steel sign rail	N.48 E.	2.1'

Corner recorded in Gogebic County in Liber 2. Page 711 on 12/10/84.

B. Description of corner evidence found and/or method applied in restoring or reestablishing corner:

Corner research on file with Gogebic County records.

Recovered the monument as described and the bearing trees as follows:

6"	Sugar Maple	N.61 W.	25.87'
9"	Sugar Maple	S.85 E.	22.20'
9"	Sugar Maple	S.36 W.	27.19'
6'	Steel sign rail	N.50 E.	2.05'

A stump hole remains from the original Hemlock B.T. and a Sugar Maple stump decayed to below ground line still remains from the original Sugar B.T.

C. Description of monument for corner and accessories established to perpetuate locating the position of the corner:

New bearing tree referenced

5"	Yellow Birch	N.09 E.	39.66'

PEER GROUP APPROVED
Richard L. Drahn 6/17/98
COUNTY REPRESENTATIVE

STATE OF MICHIGAN
RICHARD L. DRAHN
LAND SURVEYOR
No. 21564
REGISTERED LAND SURVEYOR

Signed by Richard L. Drahn Date June 16, 1998

Surveyor's Michigan License No. 21564

USFS V-1

FORM APPROVED BY MICHIGAN STATE BOARD OF LAND SURVEYORS, JAN. 28, 1971
REVISED MAY 14, 1975
REVISED JAN., 1983