

**SURVEY &
MONUMENTATION**

JAN 05 2001

SECTION

LAND CORNER RECORDATION CERTIFICATE
Filing Requirement of Act 74, Mich. P.A. 1970

Register's Office }
Gogebic County } ss.

For corners in

Gogebic
(County)

Located In:

Corner Code #

- | | | |
|------------------------------------|--|------------|
| 1. Public Land Survey | T <u>48</u> N R <u>45</u> W | B-5 |
| | T <u> </u> R <u> </u> | <u> </u> |
| | T <u> </u> R <u> </u> | <u> </u> |
| | T <u> </u> R <u> </u> | <u> </u> |
| 2. Property Controlling in Section | S <u> </u> T <u> </u> R <u> </u> | <u> </u> |
| | S <u> </u> T <u> </u> R <u> </u> | <u> </u> |
| 3. Miscellaneous Property in Sec. | S <u> </u> T <u> </u> R <u> </u> | <u> </u> |
| | S <u> </u> T <u> </u> R <u> </u> | <u> </u> |

Received for record the
25TH day of AUGUST
A. D. 19 00 at 1:10 o'clock
P m., and recorded in
8 of CORNERS
on page 16
Damone Collins Deputy
Register of Deeds

Register of Deeds Stamp & File Number

4. Lot No. _____, Recorded Plat _____
5. Private Claims _____

$\frac{1}{4}$ Corner 7 & 18; T.48 N., R.45 W.
20

I, Richard L. Drahn in a field survey on July 28, 1900 do hereby state that under requirements of P.A. 74, Michigan P.A. of 1970, the corner points mentioned in lines 1 and 2 above were in conformance with regulations and rules therefore as required in the current manual of survey instructions of the United States Department of the Interior, Bureau of Land Management or by a decree of a Court of Law and /or that the corner points mentioned in lines 3, 4 and 5 above were in conformance with the rules of the Michigan Board of Land Surveyors or by a Decree of a Court of Law; established, re-established, monumented, recovered, found as expressed below:

NOTE: Not more than 2 corners, all in the same town and range, may be recorded on this certificate.

	A	B	C	D	E	F	G	H	I	J	K	L	M
1													
2	6	5	4	3	2	1							
3													
4	7	8	9	10	11	12							
5	●												
6	18	17	16	15	14	13							
7													
8	19	20	21	22	23	24							
9													
10	30	29	28	27	26	25							
11													
12	31	32	33	34	35	36							
13													

A. Description of original monument and accessories and/or subsequent restoration:

Original corner established by Austin Burt on 9/29/1848. Original B.T.s:
Fir 8" S.33 W. 27 links (17.82')
Y. Birch 8" N.40 E. 28 links (18.48')

B. Description of corner evidence found and/or method applied in restoring or reestablishing corner:

I restored the corner position at record bearing and distance from the remains of the Yellow Birch bearing tree. It is now a windthrown stump hole with shreds of Yellow Birch bark. The Fir bearing tree has been destroyed by skid trail construction.

A 3/4" iron pipe set by the Gogebic County Forestry Comm. bears S.24 W., 6.02' from the original corner location.


Corner research on file with Gogebic County records.

C. Description of monument for corner and accessories established to perpetuate locating the position of the corner:

At the corner position I set a 3/4" X 4' aluminum rod with a 3 1/2" aluminum cap and the following new bearing trees:

Red Maple	7"	N.56 W.	14.11'
Red Maple	7"	N.83 E.	21.37'
Black Ash	7"	S.32 W.	10.88'
Steel sign rail	6'	S.78 W.	2.48'

DEED GROUP APPROVED
Richard L. Drahn 8/23/00
COUNTY DEPARTMENT

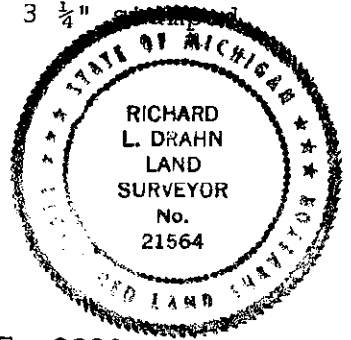

Signed by Richard L. Drahn
Surveyor's Michigan License No. 21564

Date August 17, 2000

USFS J-5