

# SURVEY & REMONUMENTATION

AUG 08 1997

COMMISSION

LAND CORNER RECORDATION CERTIFICATE  
Filing Requirement of Act 74, Mich. P.A. 1970

Register's Office }  
Gogebic County } ss.

For corners in

Gogebic  
(County)

Located In:

Corner Code #

1. Public Land Survey

T 47 N R 45 W B-1  
T 48 N R 45 W B-13

2. Property Controlling  
in Section

S T R

3. Miscellaneous  
Property in Sec.

S T R

4. Lot No. \_\_\_\_\_, Recorded Plat \_\_\_\_\_

5. Private Claims \_\_\_\_\_

1/4 cor. comm. to sec's. 6 & 31

I, John P. Goss, in a field survey on April 29 1997 do hereby state that under requirements of P.A. 74, Michigan P.A. of 1970, the corner points mentioned in lines 1 and 2 above were in conformance with regulations and rules therefore as required in the current manual of survey instructions of the United States Department of the Interior, Bureau of Land Management or by a decree of a Court of Law and for that the corner points mentioned in lines 3, 4 and 5 above were in conformance with the rules of the Michigan Board of Land Surveyors or by a Decree of a Court of Law; established, re-established, monumented, recovered, found as expressed below.

NOTE: Not more than 2 corners, all in the same town and range, may be recorded on this certificate.

Received for record the  
13<sup>TH</sup> day of MAY  
A. D. 1997 at 2:05 o'clock  
P m., and recorded in  
Liber 6 of CORNERS  
on page 112  
Armona Collins Deputy  
Register of Deeds

Register of Deeds Stamp & File Number

|    |    |    |    |    |    |    |   |   |   |   |   |   |   |
|----|----|----|----|----|----|----|---|---|---|---|---|---|---|
|    | A  | B  | C  | D  | E  | F  | G | H | I | J | K | L | M |
| 1  | ●  |    |    |    |    |    |   |   |   |   |   |   |   |
| 2  | 6  | 5  | 4  | 3  | 2  | 1  |   |   |   |   |   |   |   |
| 3  |    |    |    |    |    |    |   |   |   |   |   |   |   |
| 4  | 7  | 8  | 9  | 10 | 11 | 12 |   |   |   |   |   |   |   |
| 5  |    |    |    |    |    |    |   |   |   |   |   |   |   |
| 6  | 18 | 17 | 16 | 15 | 14 | 13 |   |   |   |   |   |   |   |
| 7  |    |    |    |    |    |    |   |   |   |   |   |   |   |
| 8  | 19 | 20 | 21 | 22 | 23 | 24 |   |   |   |   |   |   |   |
| 9  |    |    |    |    |    |    |   |   |   |   |   |   |   |
| 10 | 30 | 29 | 28 | 27 | 26 | 25 |   |   |   |   |   |   |   |
| 11 |    |    |    |    |    |    |   |   |   |   |   |   |   |
| 12 | 31 | 32 | 33 | 34 | 35 | 36 |   |   |   |   |   |   |   |
| 13 | ●  |    |    |    |    |    |   |   |   |   |   |   |   |

A. Description of original monument and accessories and/or subsequent restoration:

Original corner established by Austin Burt on 5 Sept. 1847. Set Hemlock post.  
Original bearing trees: Lynn 22" N 22° E 33 links  
Sugar 12" N 80° W 20 links

John R. Garske set a 2" brass cap in concrete filled 2" dia. pipe at corner location by single proportionate measurement on May 16, 1986. He recorded said corner in Liber 2 page 783 of Land Corners for Gogebic County. He established the following bearing trees: 6" Spruce - N 27° E - 15.29'; 6" Spruce - S 80° E - 26.05'; 6" Spruce - S 20° E - 21.48. He set D.H. Nail with cap in above bearing trees.

B. Description of corner evidence found and/or method applied in restoring or reestablishing corner:

No original evidence found.  
I found the 2" brass cap and Iron pipe and it checked with John Garske witnesses. I updated the accessories as noted below to state and county specification.


Act 74 research on file.

C. Description of monument for corner and accessories established to perpetuate locating the position of the corner:

From the 2" I.D. Pipe and 2" brass cap marked T 47-48 N, R. 45 W.; 1/4; S-31, S-6, 1986; L.S. 28410. I established the new and existing bearing trees and reference object.

|                |         |        |  |
|----------------|---------|--------|--|
| 9" Spruce      | N 27° E | 15.29' |  |
| 9" Spruce      | S 80° E | 26.05' |  |
| 8" Spruce      | S 20° E | 21.48' |  |
| 6" Poplar      | S 78° W | 15.94' |  |
| 6' Rail & sign | N 07° W | 1.2'   |  |

PEER GROUP APPROVED  
Richard L. Deahn 5/12/97  
COUNTY REPRESENTATIVE

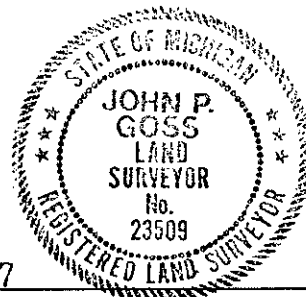

Note: Nail & cap set in side of above trees.

Signed by John P. Goss  
Surveyor's Michigan License No. 23509

Date April 30, 1997

Fed. No. A-3