

**SURVEY &
MONUMENTATION**

JAN 05 2001

SECTION

LAND CORNER RECORDATION CERTIFICATE
Filing Requirement of Act 74, Mich. P.A. 1970

For corners in

<u>Gogebic</u> (County)	Located In:	Corner Code #
1. Public Land Survey	T 48NR 45W	C-2
	T ___ R ___	_____
	T ___ R ___	_____
	T ___ R ___	_____
2. Property Controlling in Section	S ___ T ___ R ___	_____
	S ___ T ___ R ___	_____
3. Miscellaneous Property in Sec.	S ___ T ___ R ___	_____
	S ___ T ___ R ___	_____

Register's Office }
Gogebic County } ss.

Received for record the
25TH day of AUGUST
A. D. 2000 at 1:20 o'clock
P m., and recorded in
Liber B of CORNERS
on page 18
Ramona Collins, Deputy
Register of Deeds

Register of Deeds Stamp & File Number

4. Lot No. _____, Recorded Plat _____
5. Private Claims _____

$\frac{1}{2}$ Corner 5 & 6; T.48 N., R.45 W.
20

I, Richard L. Drahn in a field survey on July 31, 2000 do hereby state that under requirements of P.A. 74, Michigan P.A. of 1970, the corner points mentioned in lines 1 and 2 above were in conformance with regulations and rules therefore as required in the current manual of survey instructions of the United States Department of the Interior, Bureau of Land Management or by a decree of a Court of Law and /or that the corner points mentioned in lines 3, 4 and 5 above were in conformance with the rules of the Michigan Board of Land Surveyors or by a Decree of a Court of Law; established, re-established, monumented, recovered, found as expressed below:

NOTE: Not more than 2 corners, all in the same town and range, may be recorded on this certificate.

A	B	C	D	E	F	G	H	I	J	K	L	M
1												
2	6	●	5		4		3		2		1	
3												
4	7		8		9		10		11		12	
5												
6	18		17		16		15		14		13	
7												
8	19		20		21		22		23		24	
9												
10	30		29		28		27		26		25	
11												
12	31		32		33		34		35		36	
13												

A. Description of original monument and accessories and/or subsequent restoration:

Original corner established by Austin Burt on 9/30/1848. Original B.T.s:
Hemlock 18" S.57 $\frac{1}{2}$ W. 11 links (7.26')
Hemlock 12" N.53 E. 23 links (15.18')

B. Description of corner evidence found and/or method applied in restoring or reestablishing corner:

I restored the corner position at record bearing and distance from the remains of the two original B.T.s. The first is a 20-30" Hemlock stump decayed to near ground level. The second on is now a large series of root holes with Hemlock bark and fragments of Hemlock wood. A downed picket and a 7" Cedar stub, squared for the corner bears S.80 W., 20.8 feet from the original corner location.


Corner research on file with Gogebic County records.

C. Description of monument for corner and accessories established to perpetuate locating the position of the corner:

At the corner position I set a 3/4" X 4' solid aluminum marsh rod with a 3/4" stamped aluminum cap and the following new bearing trees:

White Pine	15"	N.65 E.	11.77'
Cedar	5"	S.14 W.	11.20'
Hemlock	12"	N.60 W.	22.70'
Steel sign rail	6'	N.27 W.	2.76'

PEER GROUP APPROVED
Richard L. Drahn 8/23/00
COUNTY REGISTRAR

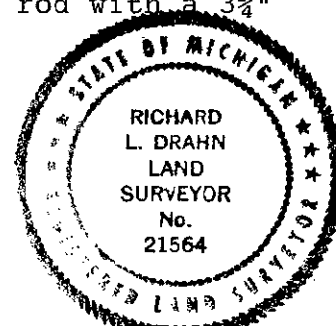

Signed by Richard L. Drahn
Surveyor's Michigan License No. 21564

Date August 17, 2000

USFS C-5