

**SURVEY &
REMONUMENTATION**

JAN 05 2001

**LAND CORNER RECORDATION CERTIFICATE
Filing Requirement of Act 74, Mich. P.A. 1970**

For corners in **SECTION**

Register's Office }
Gogebic County } ss.

Received for record the
25th day of Aug-05
A. D. 1900 at 1:20 o'clock
9 m., and recorded in
Liber 8 of CORNERS
page 19
Ramona Collins Depetty
Register of Deeds

<u>Gogebic</u> (County)	Located In:	Corner Code #
1. Public Land Survey	T <u>48</u> N. <u>45</u> W.	<u>C-3</u>
	T ___ R ___	_____
	T ___ R ___	_____
	T ___ R ___	_____
2. Property Controlling in Section	S ___ T ___ R ___	_____
	S ___ T ___ R ___	_____
3. Miscellaneous Property in Sec.	S ___ T ___ R ___	_____
	S ___ T ___ R ___	_____

Register of Deeds Stamp & File Number

4. Lot No. _____, Recorded Plat _____
5. Private Claims _____

Section Corner 5, 6, 7 & 8; T. 48 N., R. 45 W.

I, Richard L. Drahn in a field survey on Aug. 2, 1900 do hereby state that under requirements of P.A. 74, Michigan P.A. of 1970, the corner points mentioned in lines 1 and 2 above were in conformance with regulations and rules therefore as required in the current manual of survey instructions of the United States Department of the Interior, Bureau of Land Management or by a decree of a Court of Law and /or that the corner points mentioned in lines 3, 4 and 5 above were in conformance with the rules of the Michigan Board of Land Surveyors or by a Decree of a Court of Law; established, re-established, monumented, recovered, found as expressed below:

NOTE: Not more than 2 corners, all in the same town and range, may be recorded on this certificate.

A	B	C	D	E	F	G	H	I	J	K	L	M
1												
2	6	5	4	3	2	1						
3		●										
4	7	8	9	10	11	12						
5												
6	18	17	16	15	14	13						
7												
8	19	20	21	22	23	24						
9												
10	30	29	28	27	26	25						
11												
12	31	32	33	34	35	36						
13												

A. Description of original monument and accessories and/or subsequent restoration:

Original corner established by Austin Burt on 9/30/1848. Original B.T.s:
Sugar 20" S.14 W. 11 links (7.26')
Hemlock 12" N.23 E. 27 links (17.82')

B. Description of corner evidence found and/or method applied in restoring or reestablishing corner:

I restored the corner position at record bearing and distance from the remains of the two original B.T.s. The first is a very large windthrown stump hole. The second one is now a series of root holes with Hemlock bark and wood. The 3.00 chain distance west to "Enter swamp, SW" and the 8.00 chain distance north to "Enter swamp SW" are in accord with the field notes of the original Government survey. A 1 1/4" iron pipe bears S.09 W., 20.6' from the original corner location.


Corner research on file with Gogebic County records.

C. Description of monument for corner and accessories established to perpetuate locating the position of the corner:

At the corner position I set a 30" aluminum pipe with a 3 1/4" stamped aluminum cap and the following new bearing trees:

Yellow Birch	7"	S.80 E.	25.01'
Sugar Maple	10"	N.03 W.	19.83'
Red Maple	12"	West	29.84'
Steel sign rail	6'	S.01 W.	2.75'

DEED GROUP APPROVED
Richard L. Drahn 8/23/00
COUNTY REGISTER

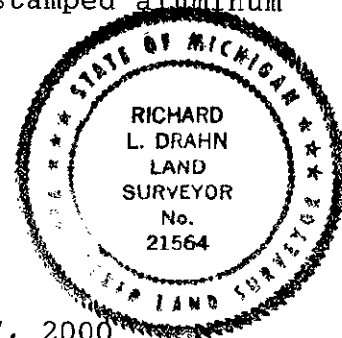

Signed by Richard L. Drahn
Surveyor's Michigan License No. 21564

Date August 17, 2000

USFSE-5