

SURVEY & MONUMENTATION

JAN 05 2001

SECTION

LAND CORNER RECORDATION CERTIFICATE

Filing Requirement of Act 74, Mich. P.A. 1970

For corners in

<u>Gogebic</u> (County)	Located In:	Corner Code #
1. Public Land Survey	T48 N R45 W.	C-6
	T R	
	T R	
	T R	
2. Property Controlling in Section	S T R	
	S T R	
3. Miscellaneous Property in Sec.	S T R	
	S T R	

Register's Office }
Gogebic County } ss.

Received for record the
2nd day of OCTOBER
A. D. 1900 at 10:50 o'clock
A m., and recorded in
Liber 8 of CORNERS
on page 2B
Ramona Collins Deputy
Register of Deeds


Register of Deeds Stamp & File Number

4. Lot No. _____, Recorded Plat _____
5. Private Claims _____

¼ Corner 17 & 18; T.48 N., R.45 W.

I, Richard L. Drahn, in a field survey on Sept 24, 2000 do hereby state that under requirements of P.A. 74, Michigan P.A. of 1970, the corner points mentioned in lines 1 and 2 above were in conformance with regulations and rules therefore as required in the current manual of survey instructions of the United States Department of the Interior, Bureau of Land Management or by a decree of a Court of Law and /or that the corner points mentioned in lines 3, 4 and 5 above were in conformance with the rules of the Michigan Board of Land Surveyors or by a Decree of a Court of Law; established, re-established, monumented, recovered, found as expressed below:

NOTE: Not more than 2 corners, all in the same town and range, may be recorded on this certificate.

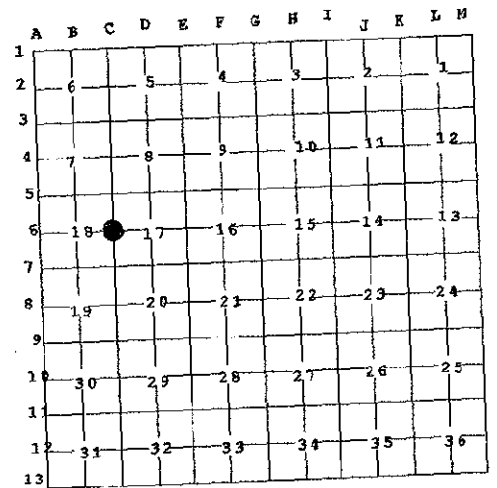

A. Description of original monument and accessories and/or subsequent restoration:

Original corner established by Austin Burt on 9/24/1848. Original bearing trees:
Hemlock 12" S.40° W. 4 links (2.64')
Sugar 10" N.33° E. 23 links (15.18')

B. Description of corner evidence found and/or method applied in restoring or reestablishing corner:

The original corner position lays in a test pit clearing. I restored the corner position at record bearing and distance from the root holes of the original Hemlock bearing tree. Hemlock wood and bark still remains. The original B.T. stump has been bulldozed NW 6 feet from its' original location. The original Sugar B.T. has been destroyed by road construction. The ½ mile distance north and south from corner to recovered section corners is in accord with the field notes of the original Government survey.

A ¾" dia. Iron pipe bears S.33° E., 32.92' from the original corner location.


Corner research on file with Gogebic County records.

C. Description of monument for corner and accessories established to perpetuate locating the position of the corner:

At the corner position I set a 2" X 30" aluminum pipe with a 3 ¼" stamped aluminum cap and the following new, blazed and scribed bearing trees: (measurements taken to a 10p nail in the side of the tree)

Red Maple	12"	N.12° W.	16.65'
Yellow Birch	7"	N.87° W.	32.11'
Red Maple	9"	S.73° E.	40.71'
Steel sign rail	6"	S.01° W.	2.30'

Richard L. Drahn 9/27/00
CORNER BENCHMARK

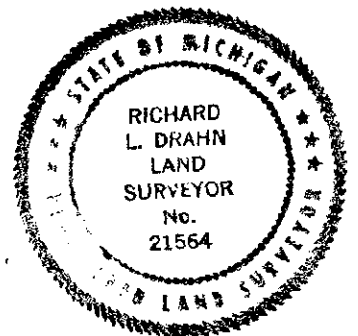

Signed by Richard L. Drahn Date September 27, 2000
Surveyor's Michigan License No. 21564

FORM APPROVED BY MICHIGAN STATE BOARD OF PROFESSIONAL SURVEYORS, JAN. 28, 1971

REVISED MAY 14, 1975
REVISED JAN., 1983
REVISED OCT., 1986