

SURVEY & REMONUMENTATION

SEP 08 1998

LAND CORNER RECORDATION CERTIFICATE
Filing Requirement of Act 74, Mich. P.A. 1970

Register's Office }
Gogebic County } ss.

For corners in SECTION

Received for record the
23RD day of JULY

A. D. 19 98 at 11:40 o'clock

A m., and recorded in
Liber 7 of CORNERS

on page 36
Ramona Collins, Deputy
Register of Deeds


Register of Deeds Stamp & File Number

_____ Gogebic _____ (County)	Located In:	Corner Code #
1. Public Land Survey	T <u>48N</u> R <u>45W</u>	<u>C-8</u>
	T _____ R _____	_____
	T _____ R _____	_____
	T _____ R _____	_____
2. Property Controlling in Section	S _____ T _____ R _____	_____
	S _____ T _____ R _____	_____
3. Miscellaneous Property in Sec.	S _____ T _____ R _____	_____
	S _____ T _____ R _____	_____

4. Lot No. _____, Recorded Plat _____
5. Private Claims _____

$\frac{1}{2}$ Corner 19 & 20; T.48 N., R.45 W.

Richard L. Drahn, in a field survey on July 8, _____, 19 98, do hereby certify that under requirements of P.A. 74, Michigan P.A. of 1970, the corner points mentioned in lines 1 and 2 above were in conformance with regulations and rules therefore as required in the current manual of survey instructions of the United States Department of the Interior, Bureau of Land Management or by a decree of a Court of Law and/or that the corner points mentioned in lines 3, 4 and 5 above were in conformance with the rules of the Michigan Board of Land Surveyors or by a Decree of a Court of Law; established, re-established, monumented, re-monumented, recovered, found as expressed below:

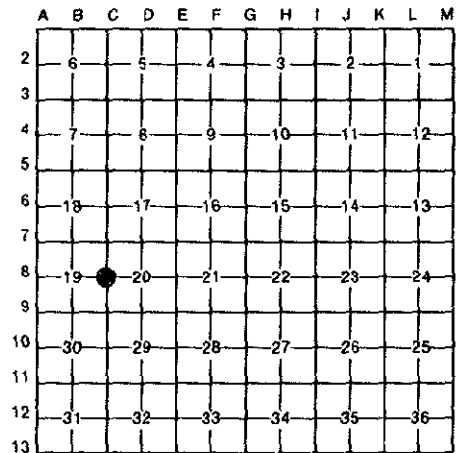

NOTE: Not more than 4 corners, all in the same town and range, may be recorded on this certificate.

A. Description of original monument and accessories and/or subsequent restoration:

Corner established by Austin Burt on 9/27/1848. Original B.T.s --- Cedar 8" N.27 E. 23 links (15.18') --- Cedar 6" N.20 W. 10 links (6.60') --- Campbell and Barron recovered the second B.T. alive and still scribed on 4/25/35.

Corner restored by Richard L. Drahn (21564) on 6/7/84 from the remains of the two original B.T.s., the 1935 tag tree and natural features N & S. He set a 3/4" X 48" aluminum rod with a 3 1/4" stamped aluminum cap and new B.T.s:

4"	Cedar	N.05 E.	12.72'
8"	Cedar	S.47 E.	23.86'
11"	Yellow Birch	S.48 W.	22.54'

B. Description of corner evidence found and/or method applied in restoring or reestablishing corner:

6'	Steel sign rail	N.84 W.	2.95'
----	-----------------	---------	-------

Corner recorded in Gogebic County Liber 2, Page 671 on 12/10/84.

Corner research on file with Gogebic County records.

Recovered the monument as described and the bearing trees as follows:

6"	Cedar	N.07 E.	12.71'
9"	Cedar	S.50 E.	23.76'
11"	Yellow Birch	S.49 W.	22.54'
6'	Steel sign rail	N.80 W.	2.88'

A shallow depression and a decayed Cedar windfall at S.20 W. still remain from the original B.T.s.

C. Description of monument for corner and accessories established to perpetuate locating the position of the corner:

New bearing tree referenced:

6"	Cedar	N.63 W.	11.20'
----	-------	---------	--------

Resource grade GPS Lat 46-32-32.21N
Long 89-58-10.67W

PEER GROUP APPROVED

Richard L. Drahn 7/22/98
COUNTY REPRESENTATIVE



Signed by Richard L. Drahn

Date July 19, 1998

Surveyor's Michigan License No. 21564