

**SURVEY &
REMONUMENTATION**

OCT 03 1996

COMMISSION

**LAND CORNER RECORDATION CERTIFICATE
Filing Requirement of Act 74, Mich. P.A. 1970**

Register's Office }
Gogebic County } ss.

For corners in

Gogebic
(County)

Located In:

Corner Code #/

- | | | |
|------------------------------------|--------------------------------|--------------|
| 1. Public Land Survey | T <u>48</u> N. R. <u>45</u> W. | <u>C-12</u> |
| | T _____ R _____ | _____ |
| | T _____ R _____ | _____ |
| | T _____ R _____ | _____ |
| 2. Property Controlling in Section | S _____ T _____ R _____ | <u>Sec-1</u> |
| | S _____ T _____ R _____ | _____ |
| 3. Miscellaneous Property in Sec. | S _____ T _____ R _____ | _____ |
| | S _____ T _____ R _____ | _____ |

Received for record the
28TH day of MARCH
A. D. 1996 at 11:30 o'clock
A m., and recorded in
Liber 5 of CORNERS
on page 338
Ramona Collins Daulty
Register of Deeds

Register of Deeds Stamp & File Number

4. Lot No. _____, Recorded Plat _____
5. Private Claims _____

Quarter corner 31 & 32; T.48 N., R.45 W.

	A	B	C	D	E	F	G	H	I	J	K	L	M
2	6		5		4		3		2		1		
3													
4	7		8		9		10		11		12		
5													
6	18		17		16		15		14		13		
7													
8	19		20		21		22		23		24		
9													
10	30		29		28		27		26		25		
11													
12	31		32		33		34		35		36		
13													

I, Richard L. Drahn in a field survey on May 15, 19 95, do hereby certify that under requirements of P.A. 74, Michigan P.A. of 1970, the corner points mentioned in lines 1 and 2 above were in conformance with regulations and rules therefore as required in the current manual of survey instructions of the United States Department of the Interior, Bureau of Land Management or by a decree of a Court of Law and/or that the corner points mentioned in lines 3, 4 and 5 above were in conformance with the rules of the Michigan Board of Land Surveyors or by a Decree of a Court of Law; established, re-established, monumented, re-monumented, recovered, found as expressed below:

NOTE: Not more than 4 corners, all in the same town and range, may be recorded on this certificate.

A. Description of original monument and accessories and/or subsequent restoration:

Original corner established by Austin Burt, Deputy Surveyor on September 27, 1848. Original bearing trees:

Cedar 8"	S.65 W.	18 links	(11.88 feet)
Cedar 12"	N.52 E.	27 links	(17.82 feet)

Corner research on file with Gogebic County records. (4/20/95)

B. Description of corner evidence found and/or method applied in restoring or reestablishing corner:

No evidence of original corner or bearing trees found. No evidence of subsequent corner restoration found. Corner position re-established on line between and equal distance from, the northwest and southwest section corners of section 32; T.48 N., R.45 W.


PEER GROUP APPROVED

Richard L. Drahn 3/27/96
COUNTY REPRESENTATIVE

C. Description of monument for corner and accessories established to perpetuate locating the position of the corner:

At the corner position I set a 2½" x 30" long aluminum monument with a 3¼" aluminum cap, stamped to read: T.48 N., R.45 W.; ¼; S-31, S-32; 1995: R.L.S. 21564. From which I established the following new blazed and scribed bearing trees.

4"	Elm	N.40 W.	48.14 feet
7"	Aspen	N.60 E.	85.35 feet
3"	Ash	S.39 W.	14.79 feet
6'	Steel rail	S.16 W.	0.96 feet

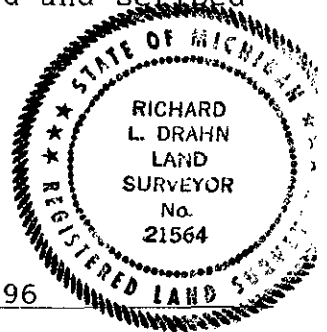

Signed by Richard L. Drahn

Date February 26, 1996

Surveyor's Michigan License No. 21564