

SURVEY & REMONUMENTATION

AUG 08 1997

COMMISSION

LAND CORNER RECORDATION CERTIFICATE
Filing Requirement of Act 74, Mich. P.A. 1970

Register's Office }
Gogebic County } ss.

For corners in

Gogebic
(County)

Located In:

Corner Code #

1. Public Land Survey

T47NR 45W	C-1
<u>T48NR 45W</u>	<u>C-13</u>
T R	
T R	
S T R	
S T R	
S T R	
S T R	

2. Property Controlling in Section

3. Miscellaneous Property in Sec.

Received for record the
11th day of JUNE
A. D. 1997 at 10:33 o'clock
A m., and recorded in
Liber 6 of CORNERS
on page 139

Callen M. Keibak, Deputy
Register of Deeds

Register of Deeds Stamp & File Number

4. Lot No. _____, Recorded Plat _____
5. Private Claims _____

A	B	C	D	E	F	G	H	I	J	K	L	M
1		●										
2	6		5		4		3		2		1	
3												
4	7		8		9		10		11		12	
5												
6	18		17		16		15		14		13	
7												
8	19		20		21		22		23		24	
9												
10	30		29		28		27		26		25	
11												
12	31		32		33		34		35		36	
13		●										

I, John P. Goss, in a field survey on May 19, 1997 do hereby state that under requirements of P.A. 74, Michigan P.A. of 1970, the corner points mentioned in lines 1 and 2 above were in conformance with regulations and rules therefore as required in the current manual of survey instructions of the United States Department of the Interior, Bureau of Land Management or by a decree of a Court of Law and/or that the corner points mentioned in lines 3, 4 and 5 above were in conformance with the rules of the Michigan Board of Land Surveyors or by a Decree of a Court of Law; established, re-established, monumented, recovered, found as expressed below:

NOTE: Not more than 2 corners, all in the same town and range, may be recorded on this certificate.


Section cor. comm. to sec's 5,6,31 & 32

A. Description of original monument and accessories and/or subsequent restoration:
Original Corner established by Austin Burt, in 1847. Set Hemlock Post.
Original bearing trees: Sugar Maple 12 - N 18° E - 31 links; Yellow Birch 22" - N 11° W - 15 links; Sugar Maple 10" - S 38° W - 40 links; Hemlock 14" - S 24° W - 28 links.
On April 5, 1963 Donald Lappala, recovered the 4 original bearing trees. He set a 2" iron pipe with 3" bronze table indicated the corner position and recorded said corner in Forest Service Record book in Register of Deeds Office for Gogebic County. He established the following bearing trees: 14" Sugar Maple N 13° E - 10.8'; 12" Yellow Birch - S 35° E - 29.0'; 15" Hemlock - S 67° W - 8.5'.
B. Description of corner evidence found and/or method applied in restoring or reestablishing corner:
Recovered the following original bearing trees: Large Stump hole - N 11° W - 15 links; Large stump hole - S 38° E - 40 links; Large stump hole - S 24° W - 28 links. Found the 2" Iron pipe with 3" bronze table and witnesses trees established by Lappala. I updated the accessories as noted below to state and county specification.

Act 74 research on file.

PEER GROUP APPROVED
Redmond P. Drach 6/10/97
COUNTY

C. Description of monument for corner and accessories established to perpetuate locating the position of the corner:
From the 2" iron pipe with 3" bronze table stamp: T 47-48 N, R.45 W.; S-5, S-6, S-31, S-32; 12585 RLS.; 1963. I established the following existing or new bearing trees and reference objects:
15" Sugar Maple N 13° E 10.75'
17" Yellow Birch S 35° E 28.96'
18" Hemlock S 67° W 8.47'
13" Sugar Maple S 77° E 18.15'
6' Rail & Sign S 22° W 1.56' (face of rail)

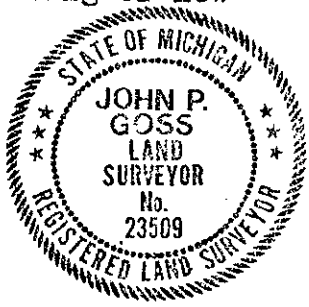

(measurement to nail in side of tree)

Signed by John P Goss Date May 20, 1997
Surveyor's Michigan License No. 23509
Fed. No. A-5