

**SURVEY & MONUMENTATION**

JAN 05 2001

SECTION \_\_\_\_\_

**LAND CORNER RECORDATION CERTIFICATE**  
Filing Requirement of Act 74, Mich. P.A. 1970

Register's Office }  
Gogebic County }

For corners in

Gogebic  
(County)

Located in:

Corner Code #

- |                                    |                           |            |
|------------------------------------|---------------------------|------------|
| 1. Public Land Survey              | T <u>48</u> N <u>45</u> W | <u>D-3</u> |
|                                    | T _____ R _____           | _____      |
|                                    | T _____ R _____           | _____      |
|                                    | T _____ R _____           | _____      |
| 2. Property Controlling in Section | S _____ T _____ R _____   | _____      |
|                                    | S _____ T _____ R _____   | _____      |
| 3. Miscellaneous Property in Sec.  | S _____ T _____ R _____   | _____      |
|                                    | S _____ T _____ R _____   | _____      |


Received for record the  
25<sup>TH</sup> day of AUGUST  
A. D. 2000 at 1:20 o'clock  
P m., and recorded in  
Liber B of CORNERS  
on page 21.  
Ramona Collins, Deputy  
Register of Deeds

Register of Deeds Stamp & File Number

4. Lot No. \_\_\_\_\_, Recorded Plat \_\_\_\_\_  
5. Private Claims \_\_\_\_\_

$\frac{1}{4}$  Corner 5 & 8; T.48 N., R.45 W.  
20

I, Richard L. Drahn in a field survey on July 31, 2000 do hereby state that under requirements of P.A. 74, Michigan P.A. of 1970, the corner points mentioned in lines 1 and 2 above were in conformance with regulations and rules therefore as required in the current manual of survey instructions of the United States Department of the Interior, Bureau of Land Management or by a decree of a Court of Law and /or that the corner points mentioned in lines 3, 4 and 5 above were in conformance with the rules of the Michigan Board of Land Surveyors or by a Decree of a Court of Law; established, re-established, monumented, recovered, found as expressed below:

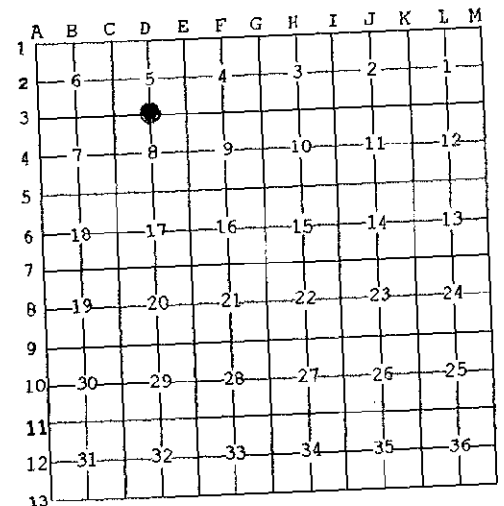

NOTE: Not more than 2 corners, all in the same town and range, may be recorded on this certificate.

A. Description of original monument and accessories and/or subsequent restoration:

Corner established by Austin Burt on 9/30/1848. Original bearing trees:  
Y. Birch 12" S.38 E. 32 links (21.12')  
Y. Birch 9" N.43 W. 18 links (11.88')

B. Description of corner evidence found and/or method applied in restoring or reestablishing corner:

The original corner location was found marked by a  $1\frac{1}{4}$ " X 4' iron pipe at record bearing and distance from the remains of the two original B.T.s. The first is a very large stump hole from a dead-in-place Yellow Birch. Fragments of Yellow Birch bark and unidentifiable hard wood are all that remains. Only a shallow depression remains of the Yellow Birch at N.43 W.


Corner research on file with Gogebic County records.

C. Description of monument for corner and accessories established to perpetuate locating the position of the corner:

At the corner position I set a 30" aluminum pipe monument with a  $3\frac{1}{4}$ " stamped aluminum cap and the following new bearing trees:

Yellow Birch	8"	N.50 E.	18.34'
Red Maple	11"	S.20 E.	7.92'
Sugar Maple	4"	N.84 W.	16.43'
Steel sign rail	6'	N.24 E.	1.75'

BEER GROUP APPROVED  
Richard L. Drahn 08/23/00  
COUNTY SURVEYOR

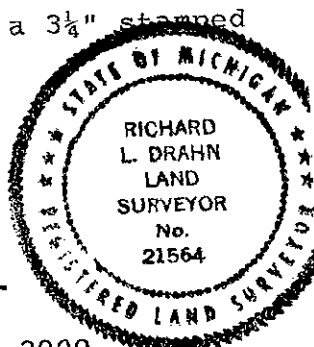

Signed by Richard L. Drahn  
Surveyor's Michigan License No. 21564

Date August 17, 2000