

**SURVEY &  
REMONUMENTATION**

OCT 0 3 1996

COMMISSION

**LAND CORNER RECORDATION CERTIFICATE**  
Filing Requirement of Act 74, Mich. P.A. 1970

Register's Office }  
Gogebic County } ss.

Received for record the  
28<sup>TH</sup> day of MARCH  
A. D. 1996 at 11:30 o'clock  
A m., and recorded in  
Liber 5 of CORNERS  
on page 339  
Ramona Collins, Deputy  
Register of Deeds

Register of Deeds Stamp & File Number

For corners in  
Gogebic  
(County)

Located In: \_\_\_\_\_ Corner Code #/ # \_\_\_\_\_

1. Public Land Survey	T <u>48</u> N R <u>45</u> W.	<u>D-11</u>
	T _____ R _____	_____
	T _____ R _____	_____
	T _____ R _____	_____
2. Property Controlling in Section	S _____ T _____ R _____	_____
	S _____ T _____ R _____	_____
3. Miscellaneous Property in Sec.	S _____ T _____ R _____	_____
	S _____ T _____ R _____	_____
4. Lot No. _____, Recorded Plat _____		
5. Private Claims _____		

A	B	C	D	E	F	G	H	I	J	K	L	M
2	6	5	4	3	2	1						
3												
4	7	8	9	10	11	12						
5												
6	18	17	16	15	14	13						
7												
8	19	20	21	22	23	24						
9												
10	30	29	28	27	26	25						
11		●										
12	31	32	33	34	35	36						
13												

Quarter Corner 29 & 32; T.48 N., R.45 W.

I, Richard L. Drahn in a field survey on June 21, 1995, do hereby certify that under requirements of P.A. 74, Michigan P.A. of 1970, the corner points mentioned in lines 1 and 2 above were in conformance with regulations and rules therefore as required in the current manual of survey instructions of the United States Department of the Interior, Bureau of Land Management or by a decree of a Court of Law and/or that the corner points mentioned in lines 3, 4 and 5 above were in conformance with the rules of the Michigan Board of Land Surveyors or by a Decree of a Court of Law; established, re-established, monumented, re-monumented, recovered, found as expressed below:

**NOTE: Not more than 4 corners, all in the same town and range, may be recorded on this certificate.**

A. Description of original monument and accessories and/or subsequent restoration:

Original corner established by Austin Burt, Deputy Surveyor on September 27, 1848. Original bearing trees:

Hemlock	14"	S.22 E.	8 links	(5.28 feet)
Cedar	12"	N.34 W.	11 links	(7.26 feet)

Corner research on file with Gogebic County records. (4/20/95)

B. Description of corner evidence found and/or method applied in restoring or reestablishing corner:

No evidence of original corner or bearing trees found. Re-established corner position on line between and equal distance from, the northeast and northwest section corners of section 32; T.48 N., R.45 W.


No evidence of subsequent corner restoration found.

**PEER GROUP APPROVED**  
Richard L. Drahn 3/27/96  
COUNTY REPRESENTATIVE

C. Description of monument for corner and accessories established to perpetuate locating the position of the corner:

At the corner position I set a 3/4" x 48" long solid aluminum rod, with a 3 1/4" aluminum cap stamped to read: T.48 N., R.45 W.; 1/4; S-29, S-32; 1995; R.L.S. 21564. From which I established the following new blazed and scribed bearing trees:

6"	Cedar	N.03 E.	23.49 feet
6"	Cedar	N.77 E.	28.91 feet
6"	Cedar	S.52 W.	9.41 feet
6'	Steel rail	S.26 E.	1.68 feet

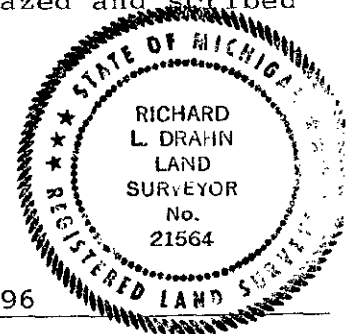

Signed by Richard L. Drahn  
Surveyor's Michigan License No. 21564

Date February 26, 1996