

SURVEY & REMONUMENTATION

SEP 08 1998

SECTION

LAND CORNER RECORDATION CERTIFICATE
Filing Requirement of Act 74, Mich. P.A. 1970

Register's Office }
Gogebic County } ss.

Received for record the
20TH day of August
A. D. 1998 at 1:20 o'clock
1 m., and recorded in
Liber 7 of CORNERS

on page 51
Ramona L. Collins, Deputy
Register of Deeds

Register of Deeds Stamp & File Number

For corners in

Gogebic
(County)

Located In:

Corner Code #

1. Public Land Survey	T <u>48N</u> R <u>45W</u>	<u>E-8</u>
	T _____ R _____	_____
	T _____ R _____	_____
	T _____ R _____	_____
2. Property Controlling in Section	S _____ T _____ R _____	_____
	S _____ T _____ R _____	_____
3. Miscellaneous Property in Sec.	S _____ T _____ R _____	_____
	S _____ T _____ R _____	_____

4. Lot No. _____, Recorded Plat _____
5. Private Claims _____

Quarter corner 20 & 21: T.48 N., R.45 W.

Richard L. Drahn, in a field survey on August 13, 19 98

do hereby certify that under requirements of P.A. 74, Michigan P.A. of 1970, the corner points mentioned in lines 1 and 2 above were in conformance with regulations and rules therefore as required in the current manual of survey instructions of the United States Department of the Interior, Bureau of Land Management or by a decree of a Court of Law and/or that the corner points mentioned in lines 3, 4 and 5 above were in conformance with the rules of the Michigan Board of Land Surveyors or by a Decree of a Court of Law; established, re-established, monumented, re-monumented, recovered, found as expressed below:

NOTE: Not more than 4 corners, all in the same town and range, may be recorded on this certificate.

Description of original monument and accessories and/or subsequent restoration:


Corner established by Austin Burt on 9/25/1848. Original B.T.s --- 8" Tamarack S.24 E. 16 links (10.56') --- 8" Tamarack N.36½ W. 42 links (27.72')
Wm. Beck & Wm. Kellan, on 4/25/35, recovered the SE B.T. still scribed and placed a location poster on the north side of a 10" Y. Birch 5' south of the corner.(B.T.).

restored the corner position at record bearing and distance from the remains of the two original B.T.s The first is a 12-14" broken Tamarack stub with GLO blazes, the measuring notch and the reverse impression of the notch. The second one is now a badly decayed Tamarack stump. The 1935 location poster

Description of corner evidence found and/or method applied in restoring or reestablishing corner:

was not recovered although the "tag" tree is now a near dead 13" Yellow Birch. 16" Cedar "sign in tree" with names and dates to 1935 bears S.12 E. 11.4'. blue paint line and very old blazed line runs N_S through the "sign in tree".

corner research on file with Gogebic County records.

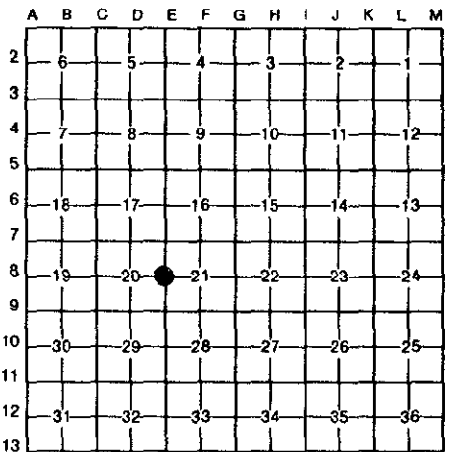

PEER GROUP APPROVED

Richard L. Drahn 8/19/98
COUNTY REPRESENTATIVE

Description of monument for corner and accessories established to perpetuate locating the position of the corner:

to the corner position I set a 3/4" X 48" long solid aluminum Marsh rod with a 3/4" aluminum cap stamped to indicate the corner and the following B.T.S:

13"	Hemlock	N.89 W.	23.29'
13"	Hemlock	S.47 W.	16.60'
6"	Hemlock	N.36 W.	27.23'
6'	Steel sign rail	S.26 E.	1.75'



Witnessed by Richard L. Drahn Date August 14, 1998

Surveyor's Michigan License No. 21564