

DEC 15 1998

SECTION

LAND CORNER RECORDATION CERTIFICATE
Filing Requirement of Act 74, Mich. P.A. 1970

For corners in

<u>Gogebic</u> (County)	Located In:	Corner Code #
1. Public Land Survey	T <u>48N</u> R <u>45W</u>	<u>E-10</u>
	T _____ R _____	_____
	T _____ R _____	_____
	T _____ R _____	_____
2. Property Controlling in Section	S _____ T _____ R _____	_____
	S _____ T _____ R _____	_____
3. Miscellaneous Property in Sec.	S _____ T _____ R _____	_____
	S _____ T _____ R _____	_____

Register's Office }
Gogebic County } ss.


Received for record the
17th day of SEPTEMBER
A. D. 1998 at 1:15 o'clock
P M., and recorded in
Liber 7 of CORNERS
on page 58
Ramona Collins, Deputy
Register of Deeds

Register of Deeds Stamp & File Number

4. Lot No. _____, Recorded Plat _____
5. Private Claims _____

$\frac{1}{4}$ Corner 28 & 29; T.48 N., R.45 W.

I, Richard L. Drahn in a field survey on August 21, 19 98, do hereby certify that under requirements of P.A. 74, Michigan P.A. of 1970, the corner points mentioned in lines 1 and 2 above were in conformance with regulations and rules therefore as required in the current manual of survey instructions of the United States Department of the Interior, Bureau of Land Management or by a decree of a Court of Law and/or that the corner points mentioned in lines 3, 4 and 5 above were in conformance with the rules of the Michigan Board of Land Surveyors or by a Decree of a Court of Law; established, re-established, monumented, re-monumented, recovered, found as expressed below.

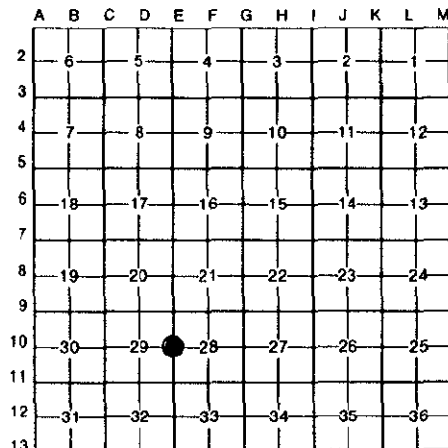

NOTE: Not more than 4 corners, all in the same town and range, may be recorded on this certificate.

A. Description of original monument and accessories and/or subsequent restoration:

Corner established by Austin Burt on 9/25/¹⁸⁴⁸~~98~~. Original B.T.s --- Fir
8" S.50 E. 27 links (17.82') --- B. Ash 10" N.40 W. 15 links (9.90') ---

B. Description of corner evidence found and/or method applied in restoring or reestablishing corner:

I restored the corner position at record bearing and distance from the remains of the original Black Ash bearing tree. It is now a very badly decayed Black Ash stump with several sprouts up to 6" diameter. No evidence remains of the Fir B.T.
The distance north to leave swamp checks to within 15'. GPS distances south to recovered section corner and north to recovered quarter corner are consistence with the original field notes.

Corner research on file with Gogebic County records.

PEER GROUP APPROVED
Richard L. Drahn 9/16/98
COUNTY SURVEYOR

C. Description of monument for corner and accessories established to perpetuate locating the position of the corner:

At the corner position I set a ^{X 4'} 3/4" aluminum rod with a 3 1/2" stamped aluminum cap and the following new B.T.s:

8"	B. Ash	N.27 E.	9.26'
7"	B. Ash	S.13 E.	8.98'
5"	B. Ash	N.33 W.	11.87'
6'	Steel sign rail	S.84 E.	2.80'



Signed by Richard L. Drahn Date August 28, 1998

Surveyor's Michigan License No. 21564